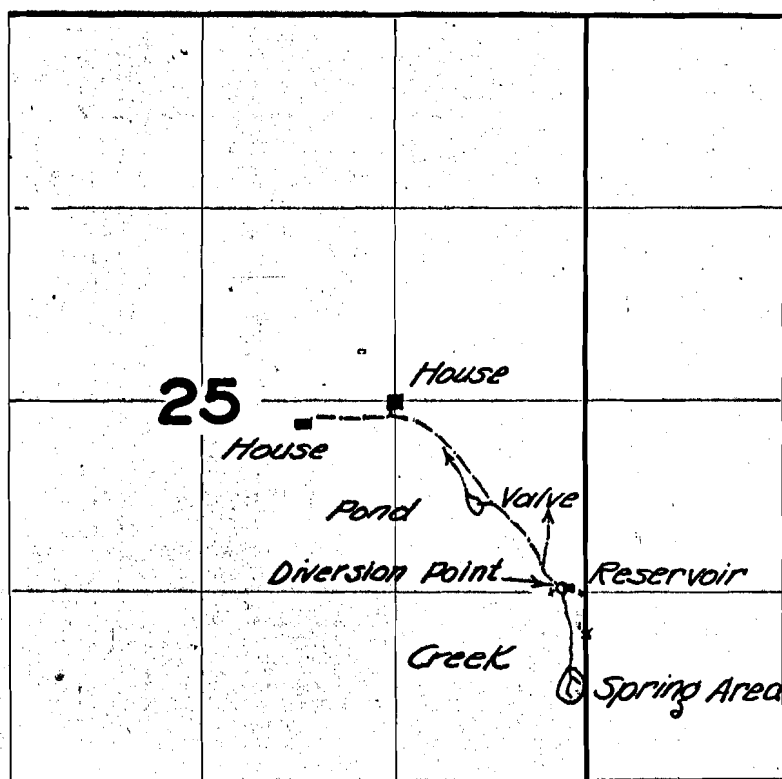


14473

19824

T.40S. R.20E. W.M.

**FINAL PROOF SURVEY**
UNDERApplication No. 18838.. Permit No. 14473..
IN NAME OF

G. G. KELSO

Surveyed JUNE 19 1951., by H.L. COFFMAN.

40-20 ✓

1051 D