


T.12 S.R.4W.W.M.

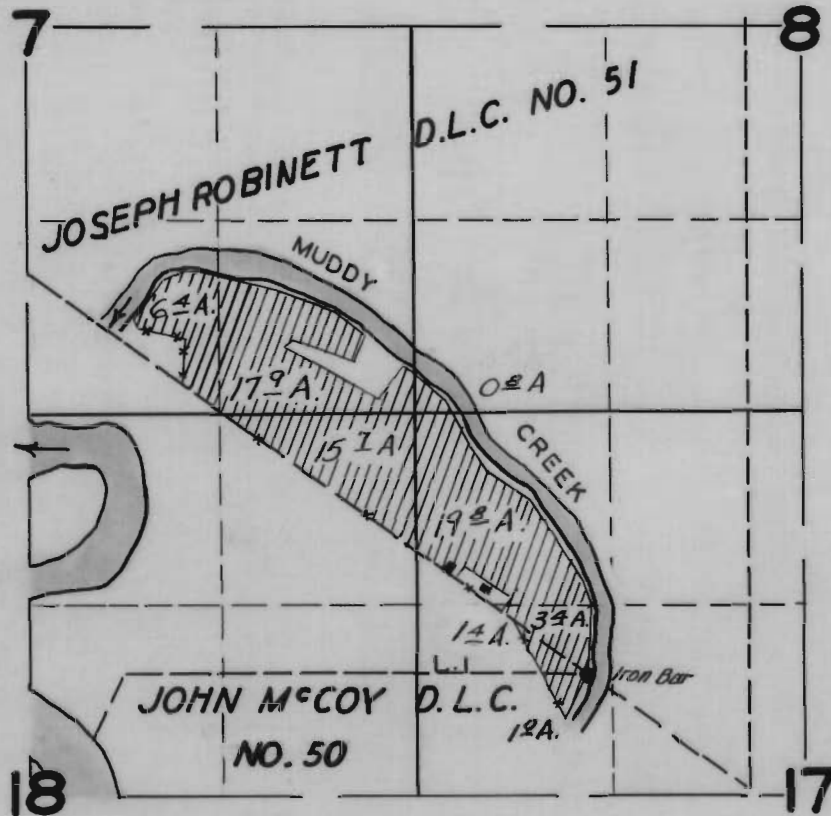

FINAL PROOF SURVEY
UNDER

Application No. 1781.1 Permit No. 13575.

IN NAME OF

F. M. LAMB

Surveyed APR. 26, 1951., by H. L. COFFMAN