


14323
19826

T.35S.R.19E.W.M.

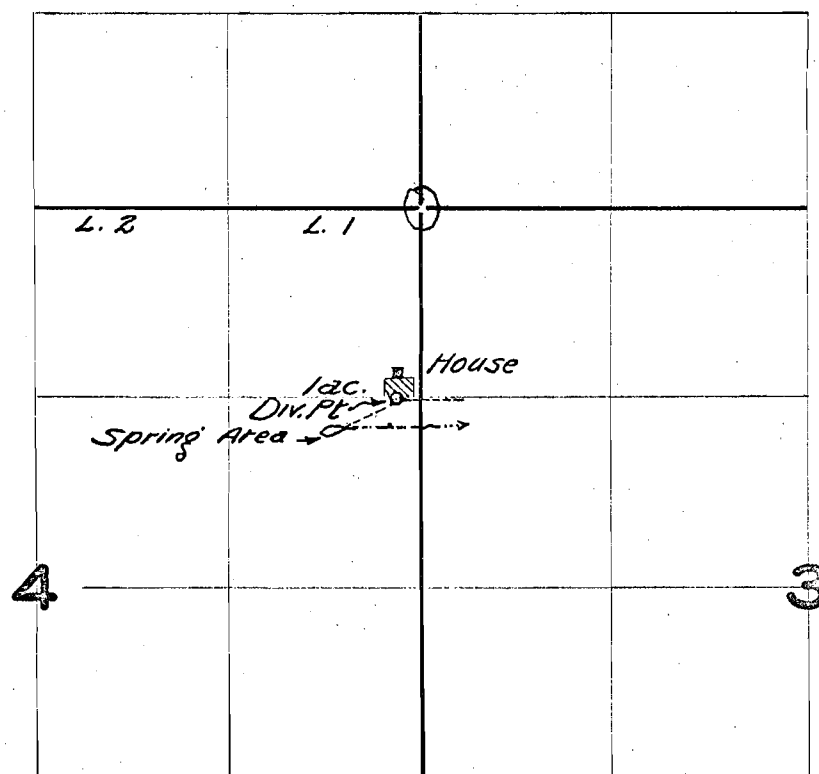

FINAL PROOF SURVEY
UNDER

Application No. 18698... Permit No. 14323...
IN NAME OF

.....CARL HOLDER.....

Surveyed JUNE 21 1951... by H.L. COFFMAN

35-19 ✓