


T.20S. R.5WWM.

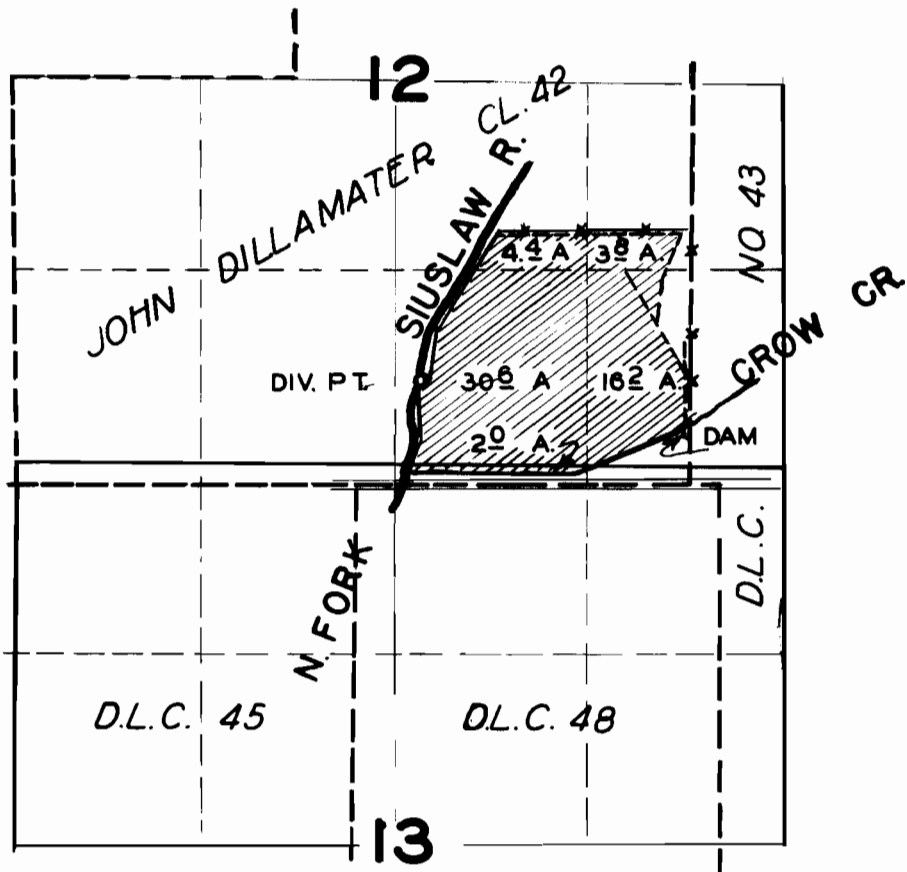

FINAL PROOF SURVEY UNDER

Application No. 19318 Permit No. 14900
IN NAME OF

PAUL R. WILLIAMSON

Surveyed MAY 1, 1951, by H.L. COFFMAN.