


T. 3 S. R. 9 W. W. M.

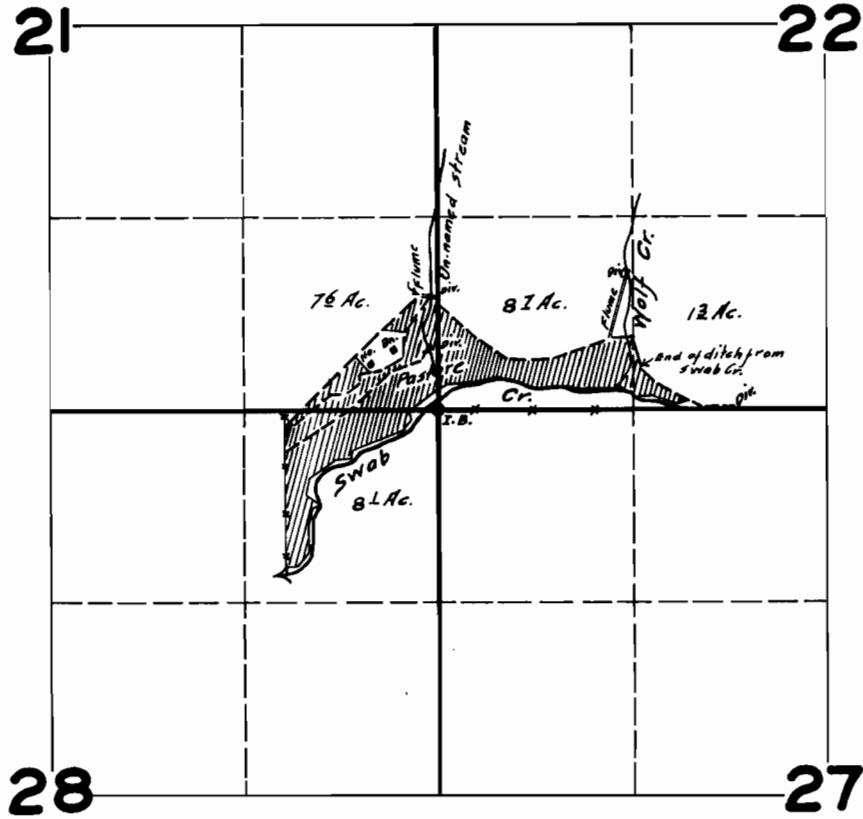

FINAL PROOF SURVEY
UNDER

Application No. 19426 Permit No. 14958

IN NAME OF
V.C. COLE

Surveyed JUNE 5, 1945, by *[Signature]*