


T.15S. R.47E. W.M.

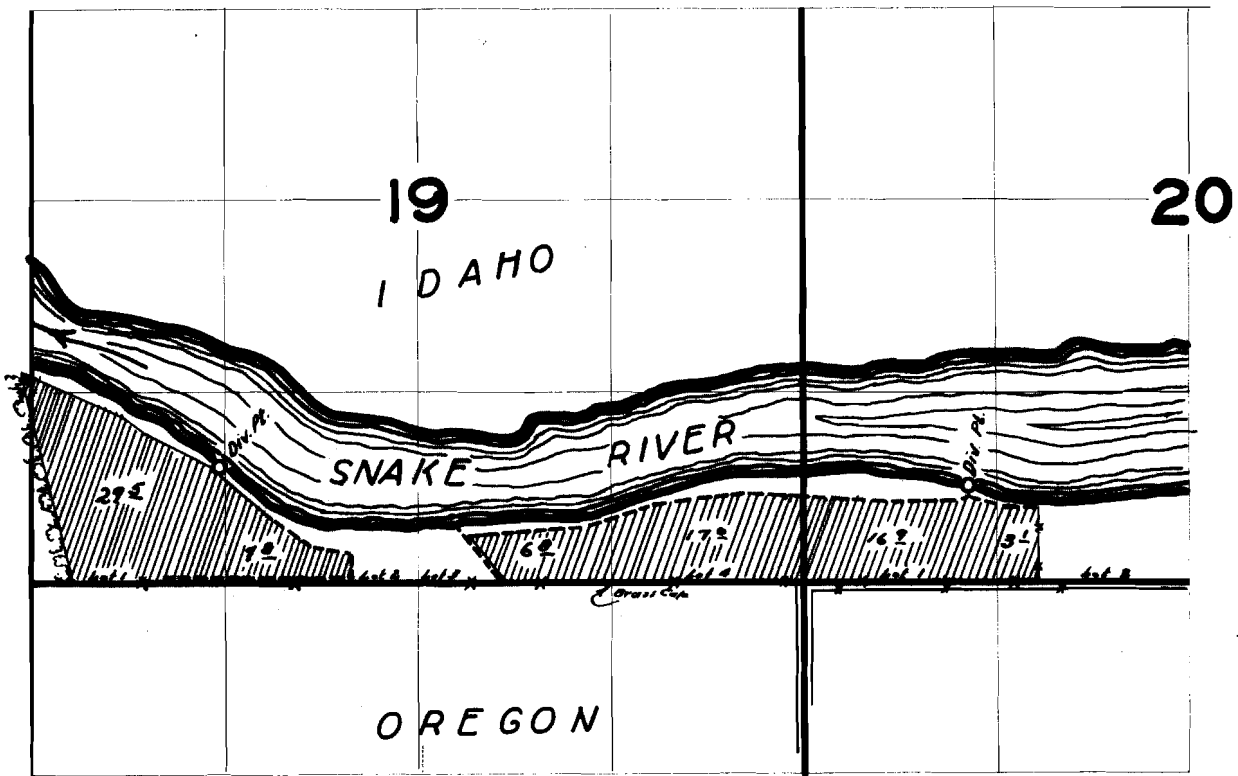

FINAL PROOF SURVEY UNDER

Application No. 19717..... Permit No. 15290...
IN NAME OF

F. & L. SHIPPY & J. L. & T. A. CROWE

Surveyed 8/21..... 1951., by H. L. COFFMAN