


T.4S.R.6W.W.M.

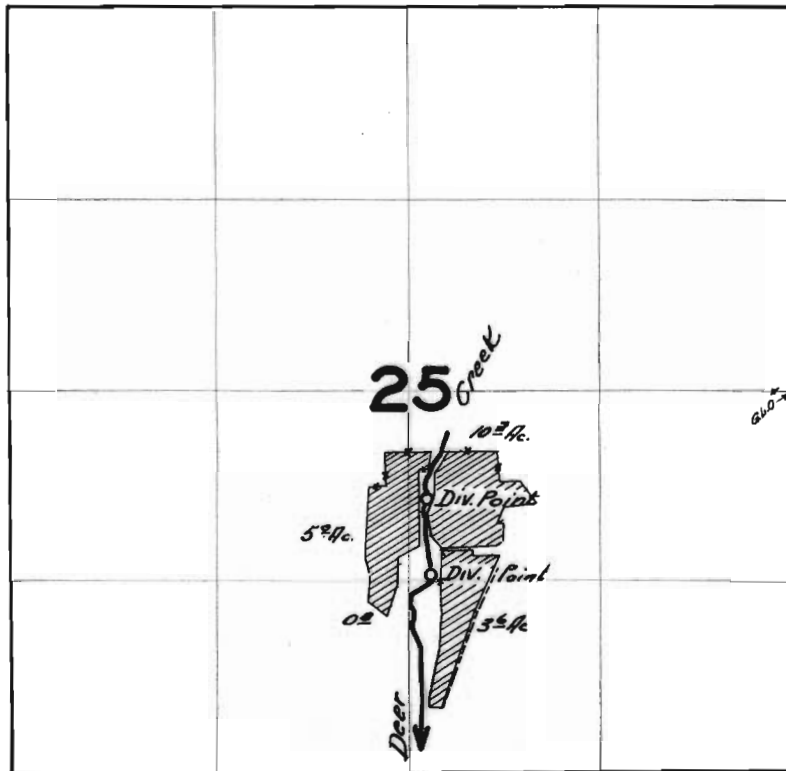

FINAL PROOF SURVEY
UNDER

Application No. 19710 Permit No. 15286
IN NAME OF

..... W. M. FAGAN

Surveyed 9/25 1951, by H. L. COFFMAN