


T.18S.R.47E.W.M.

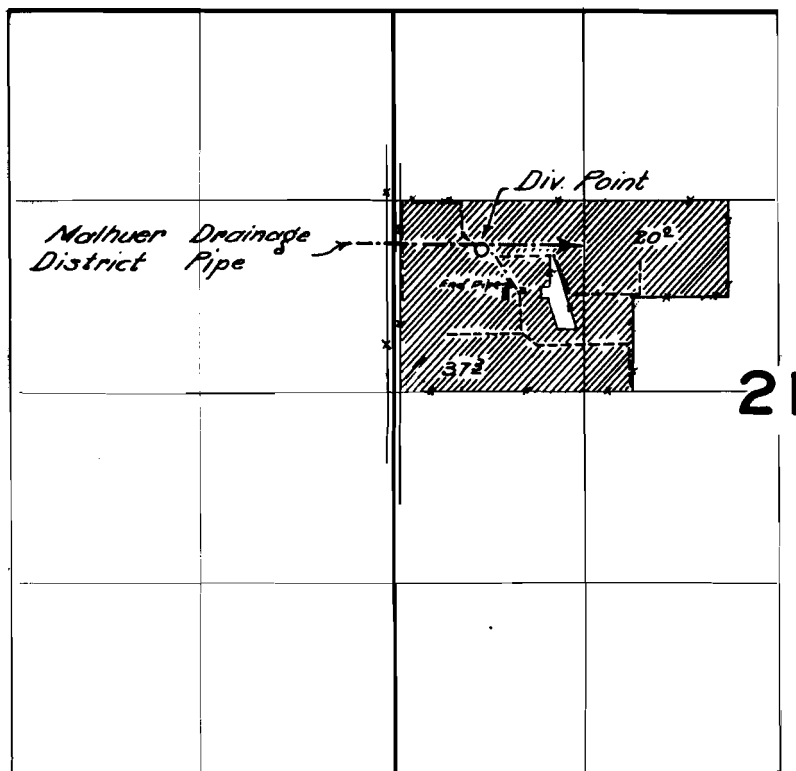

FINAL PROOF SURVEY

UNDER

Application No. 20492. Permit No. 16059...

IN NAME OF

J. R. WALLACE

Surveyed 8 / 23 1951, by H. L. COFFMAN