


T. 1 N. R. 3 W. W. M.

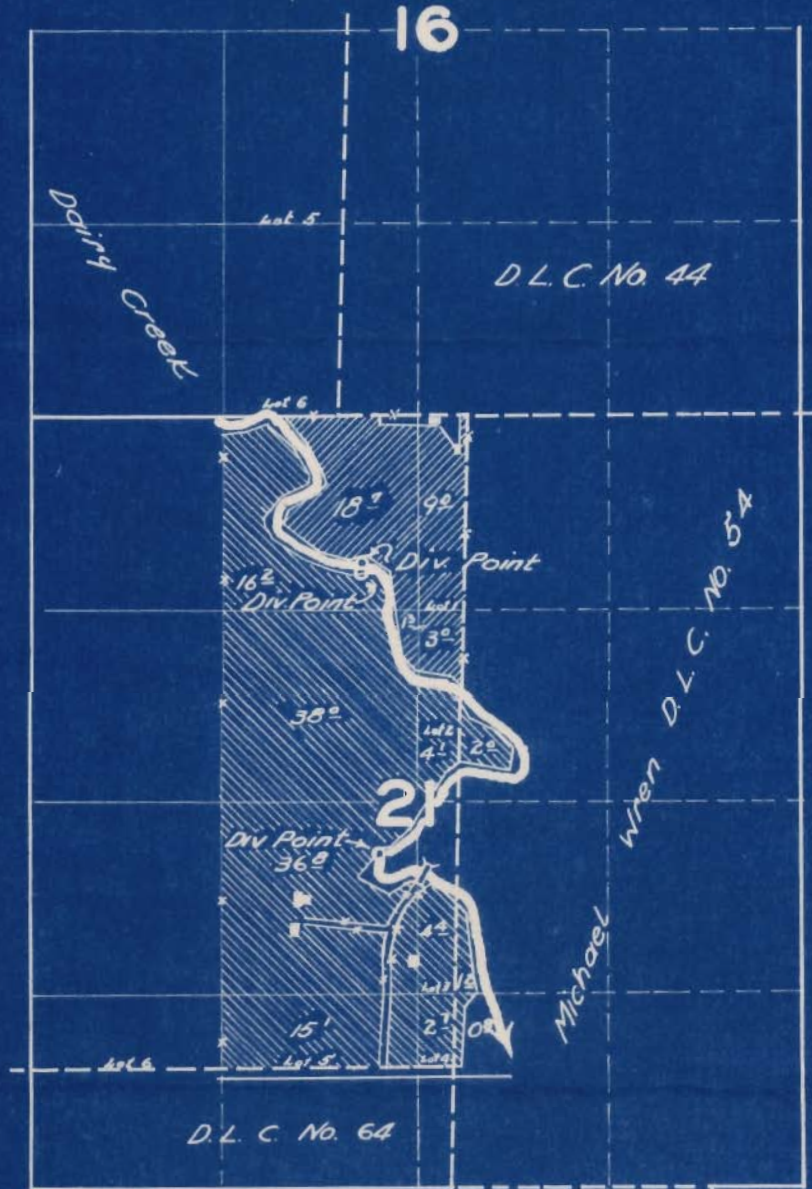

FINAL PROOF SURVEY

UNDER

APPLICATION 20736 PERMIT 16211  
APPLICATION 19489 PERMIT 15069

JOHN HERINCKX  
ADDIE MARSH

APP. 20736



APP. 19489



Surveyed 8/2 1951, by H.L. COFFMAN