


# T.2S.R.1W.W.M.

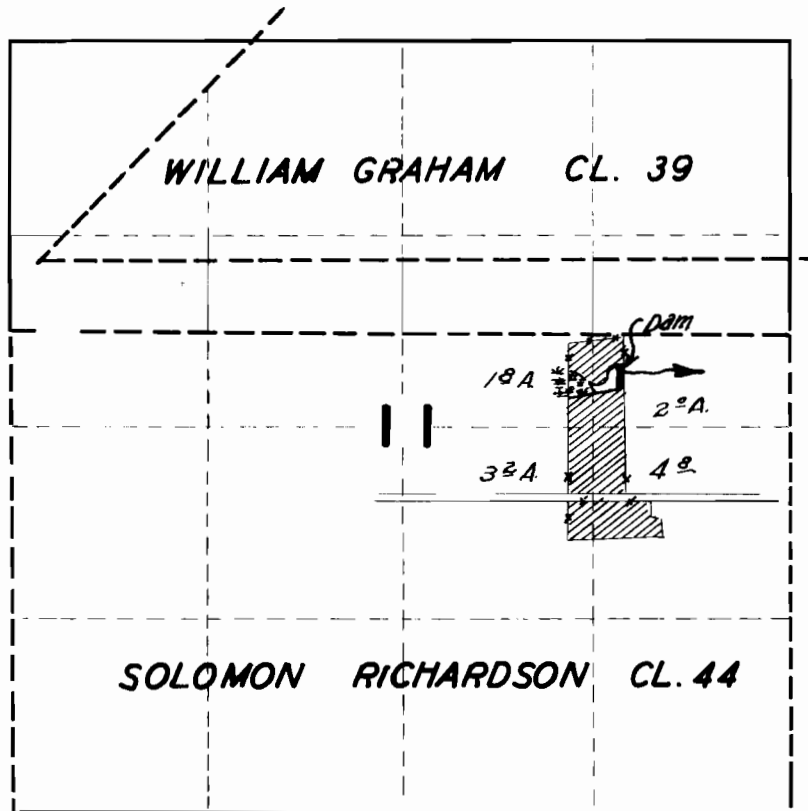

## FINAL PROOF SURVEY

UNDER

Application No. 20743... Permit No. 16235...

IN NAME OF

..... EDWARD J. SATTLER .....

Surveyed MAY 11, 1951, by H.L. COFFMAN