


T.5S. R.3W.W.M.

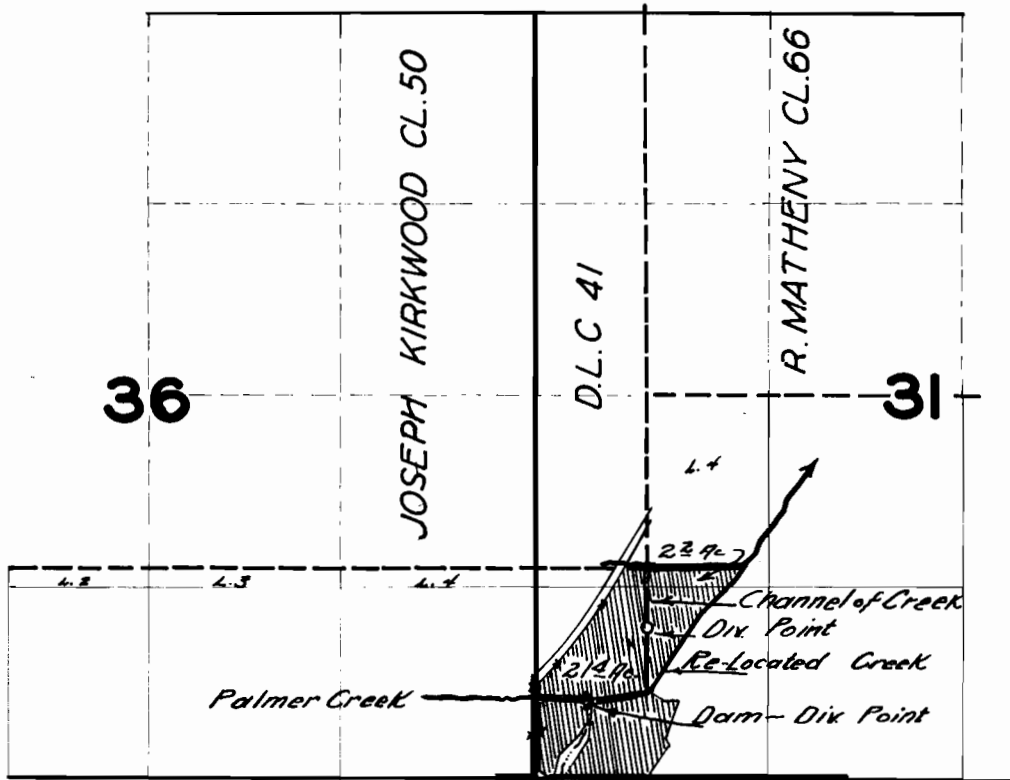



Section 20895 Section 16365

PLAT 1000

NEIL D. CURRIE

Surveyed 9/11 1951, by H.L. COFFMAN