


# T.5S. R.6W.W.M.

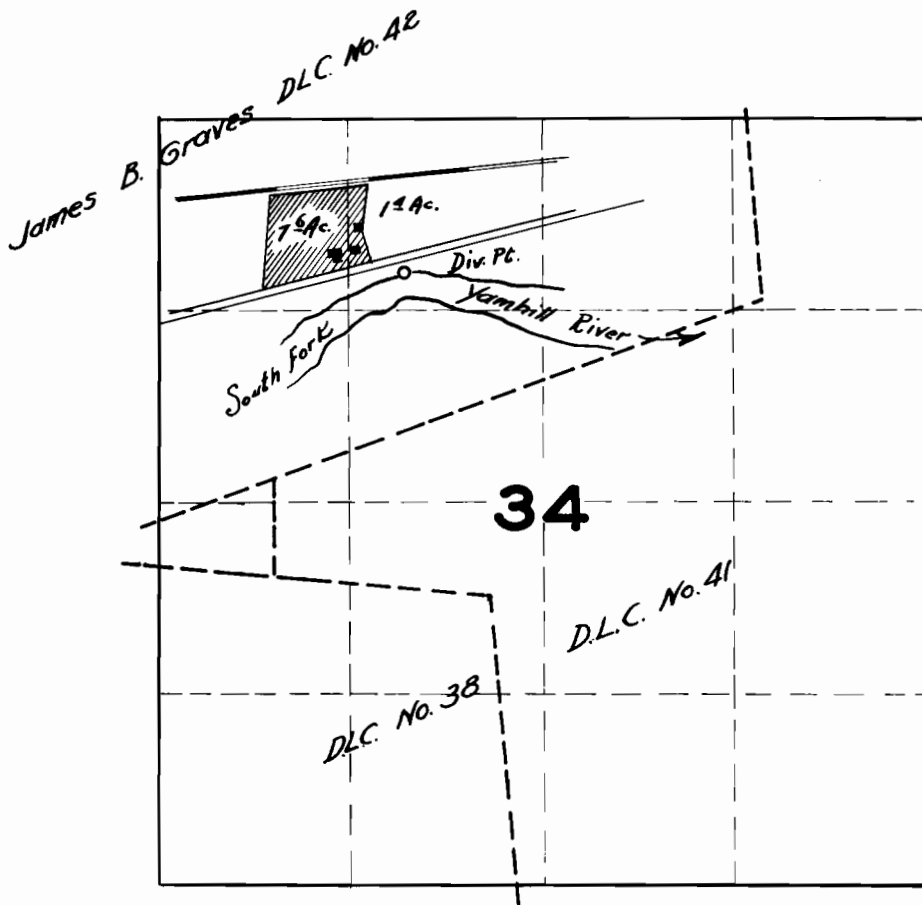

## FINAL PROOF SURVEY

UNDER

Application No. 21121 ... Permit No. 16551 ...

IN NAME OF

WALTER W. SANDSTROM

Surveyed 10.7.1951, by H.L. COFFMAN