


T.2S. R.1W.WM.

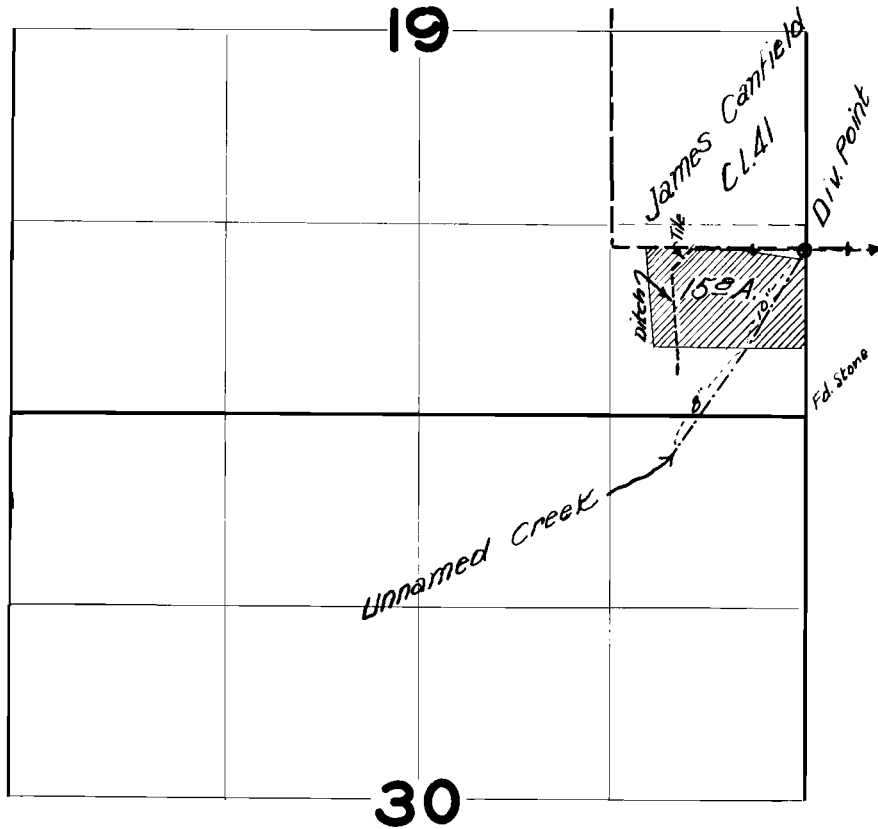

FINAL PROOF SURVEY

UNDER

Application No. 21234 Permit No. 16643

IN NAME OF

SHERMAN SEELY

Surveyed MAY 8 1951, by H.L. COFFMAN