


T.17S.R4W.W.M.

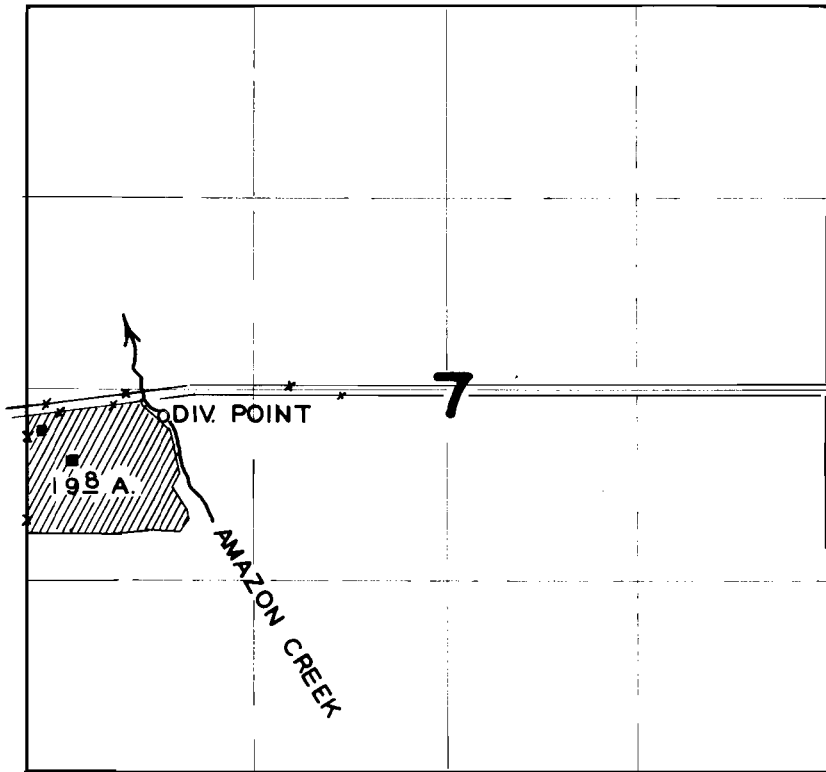

**FINAL PROOF SURVEY**  
UNDER

Application No. 21298. Permit No. 16701.  
IN NAME OF

MARGARET NICKERSON

Surveyed MAY 4 1951, by H.L. COFFMAN.