


T.22&23S.R.31E.W.M.

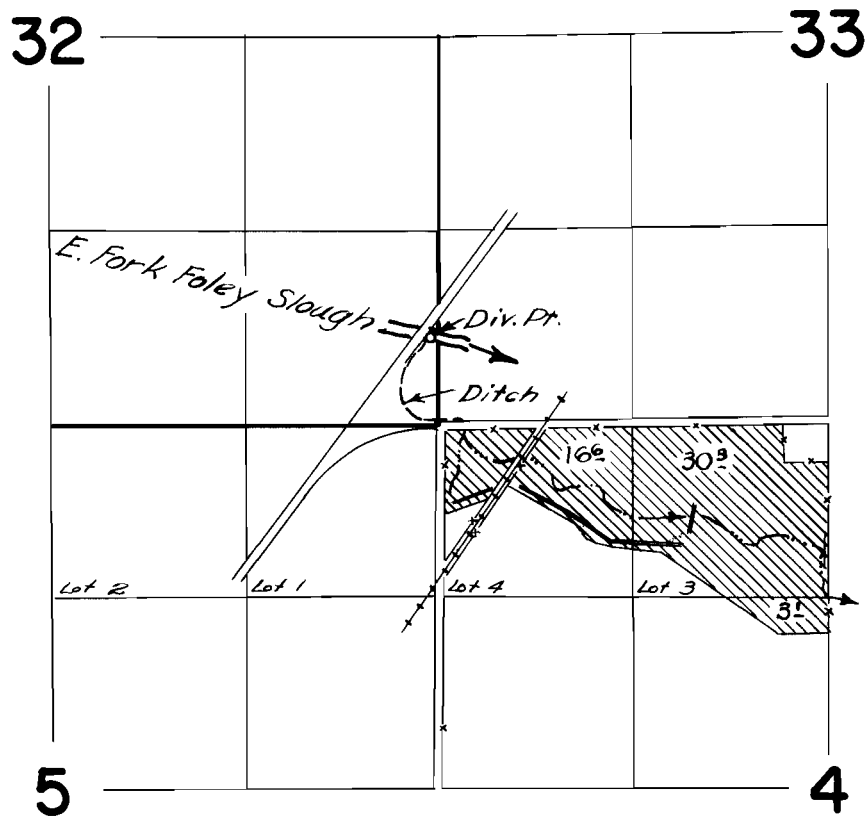

FINAL PROOF SURVEY
UNDER

Application No. **21734** Permit No. **17108**
IN NAME OF

LESTER TYLER

Surveyed, July 17 1951, by H.L. Coffman