


T.5S. R.5W.W.M.

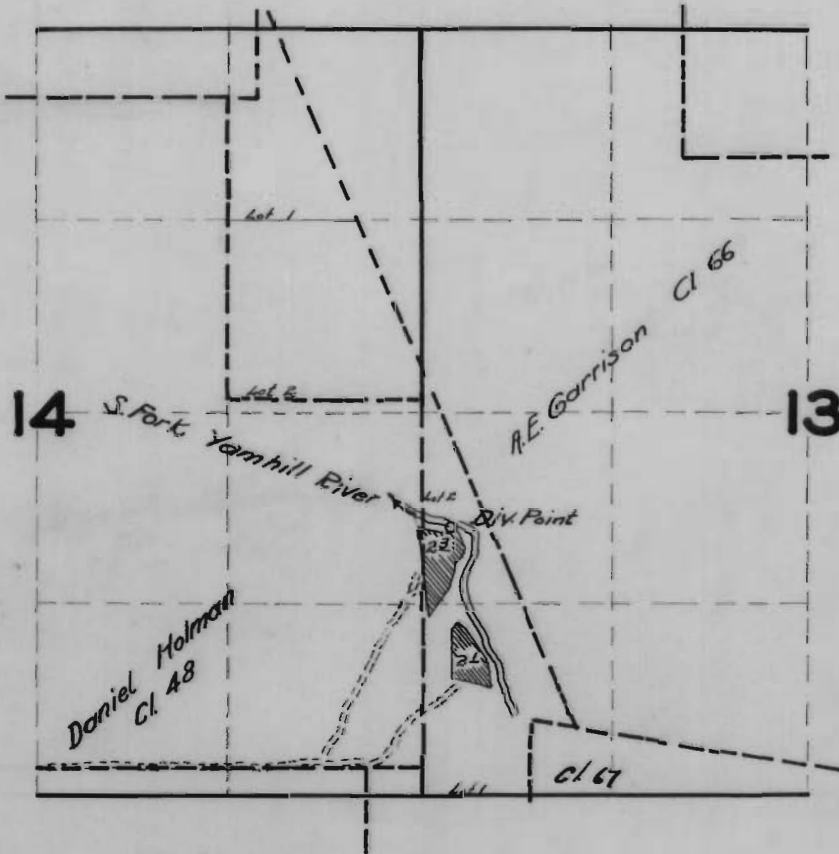

FINAL PROOF SURVEY

UNDER

Application No. 21779 Permit No. 17133

IN NAME OF

FLOYD W. JACKSON

Surveyed 9 / 18 1951, by H.L. COFFMAN