


T.1N.R.2&3E.W.M.

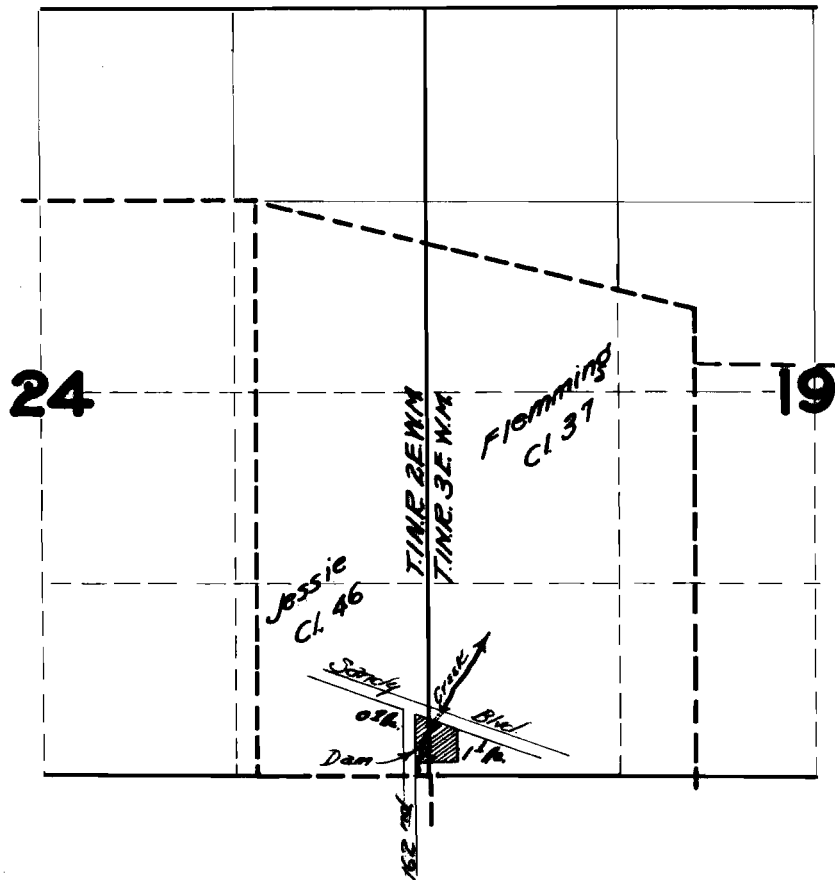

FINAL PROOF SURVEY

UNDER

Application No. ~~21045~~ Permit No. 17343..
IN NAME OF

.....R. E. DRAKE & E. T. JOHNSON.....

Surveyed OCT. 18. 1951., by H. L. COFFMAN..