


SECTION

TOWNSHIP 33 S., RANGE 5 W., W. M.

North

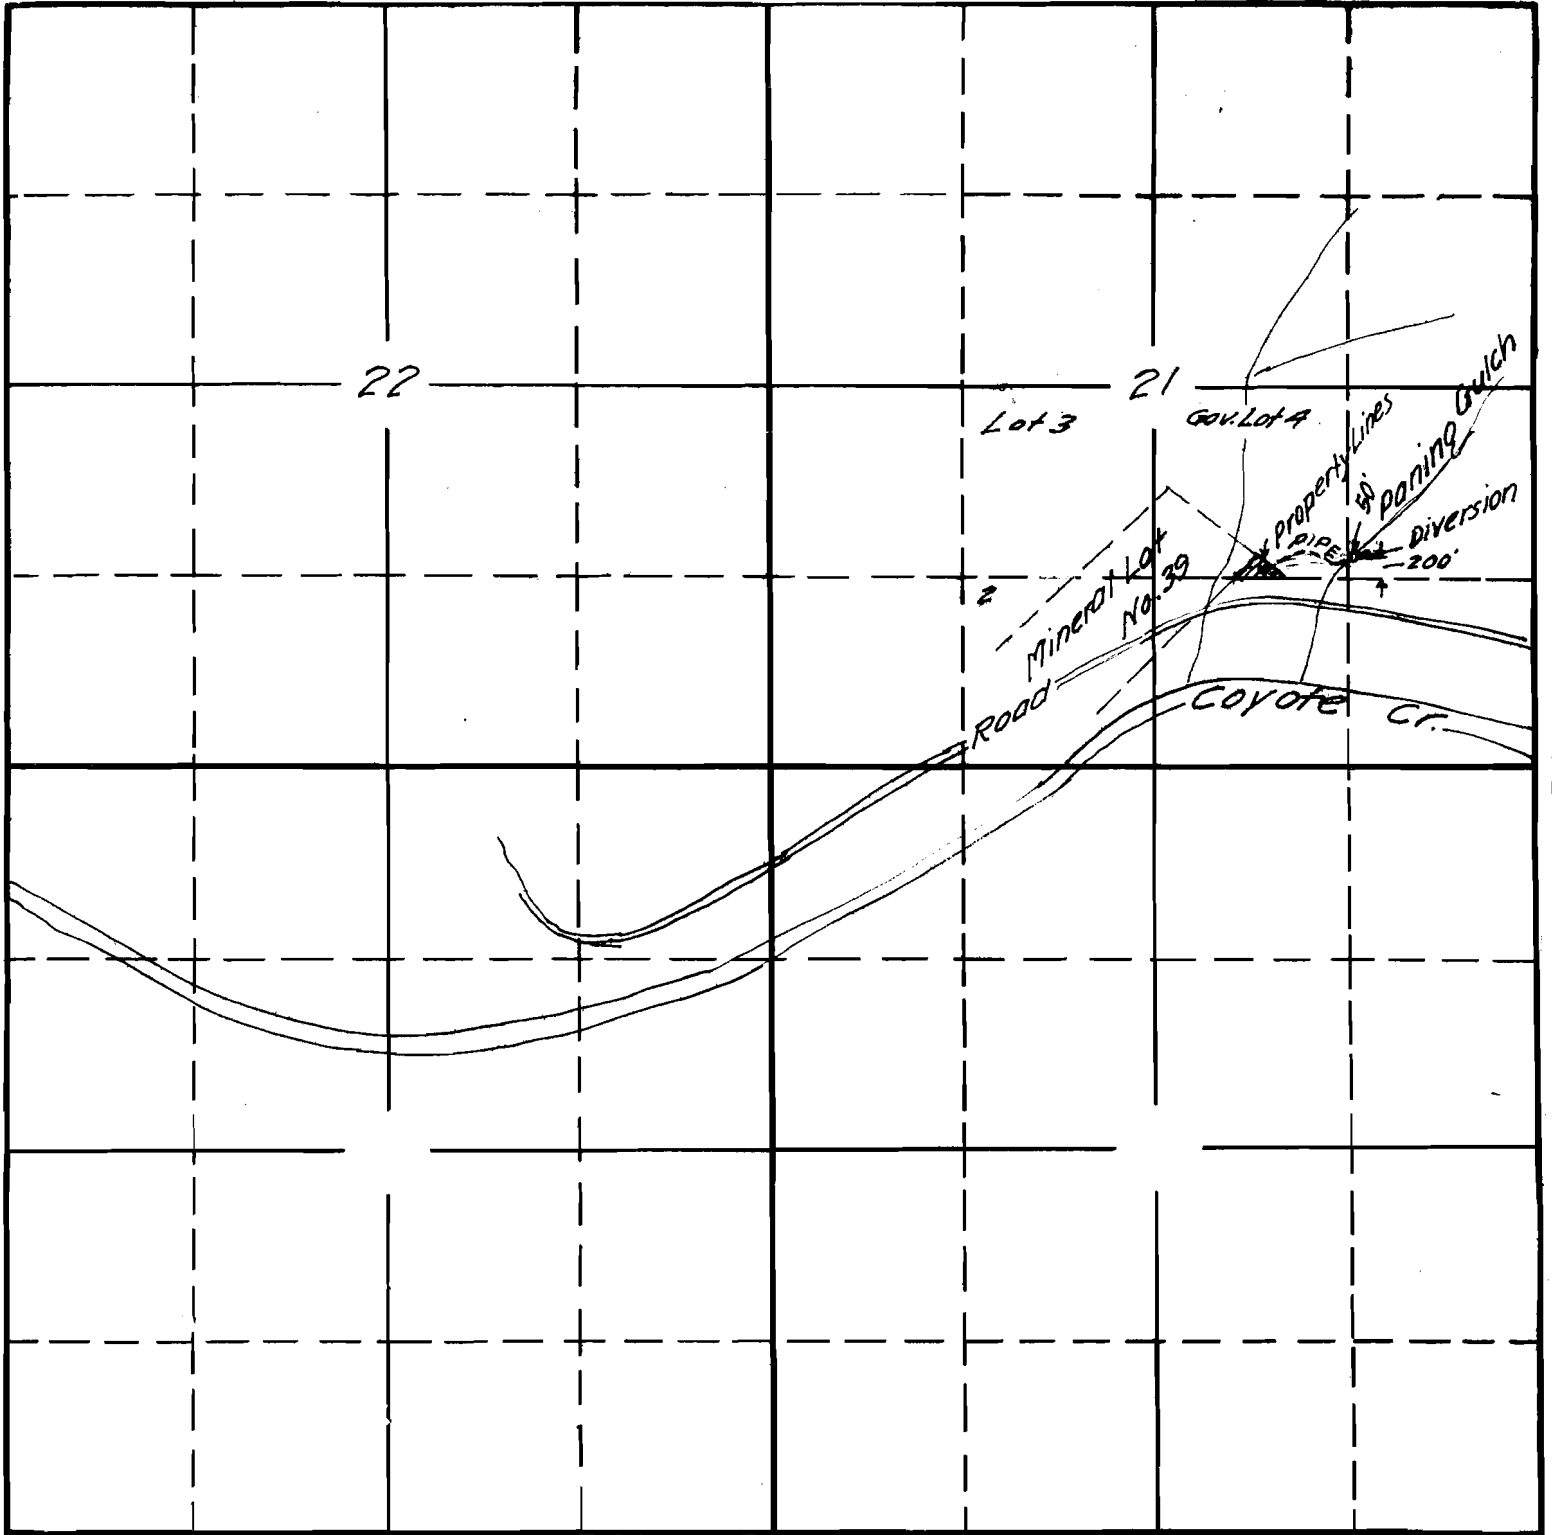

South

O. E. WYER
Feb. 1947

APPLICATION No. 22266

PERMIT No. 1700