


T. 1 N. R. 3 W. W. M.

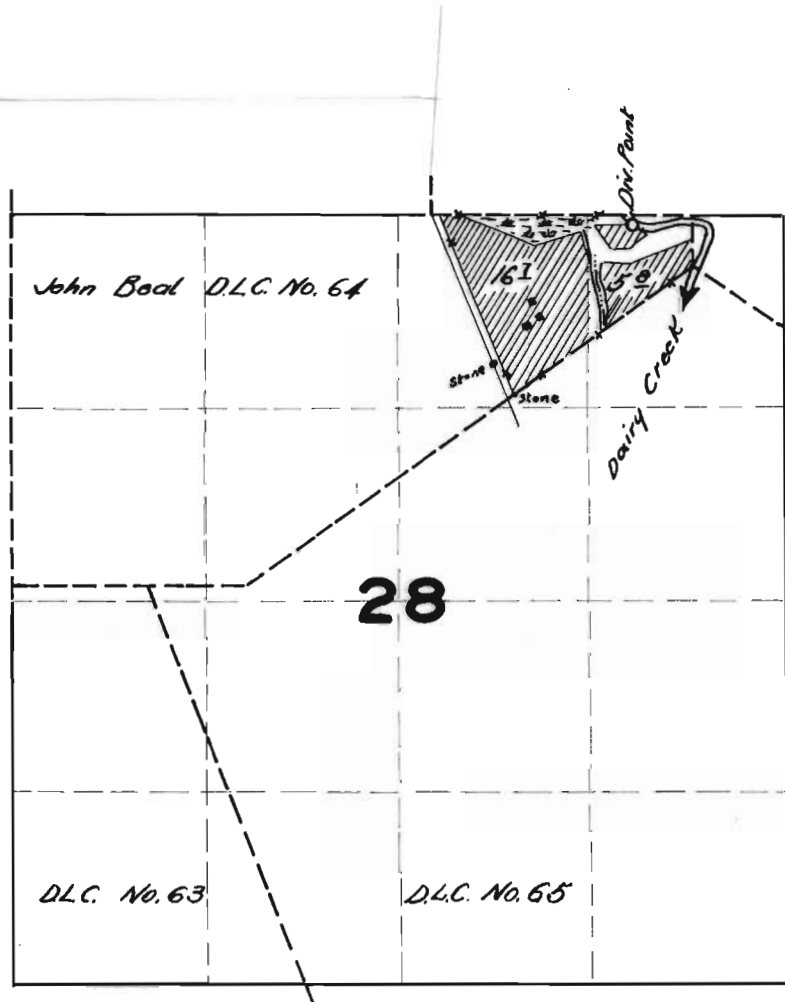

FINAL PROOF SURVEY

UNDER

Application No. 22359 Permit No. 17628

IN NAME OF

HERBERT M. ROBINSON

Surveyed 8/2 1951, by H.L. COFFMAN