


T.7S. R. 1 W.W.M.

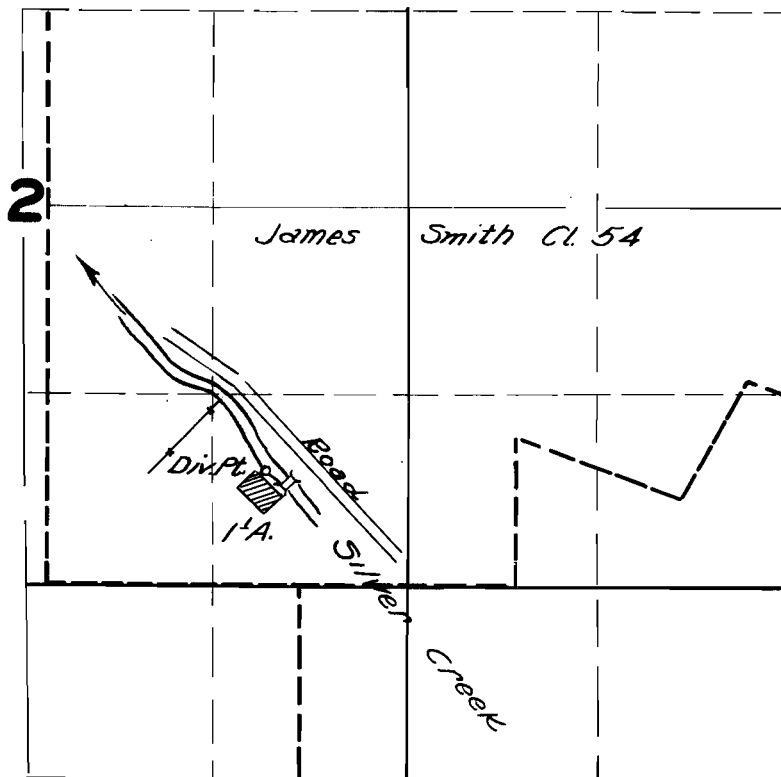

**FINAL PROOF SURVEY**

UNDER


Application No. 22387. Permit No. 17648.

IN NAME OF

ROY C. GOSSO

Surveyed AUG. 28. 1950., by H.L. COFFMAN.

T.7S. R. 1 W.W.M.

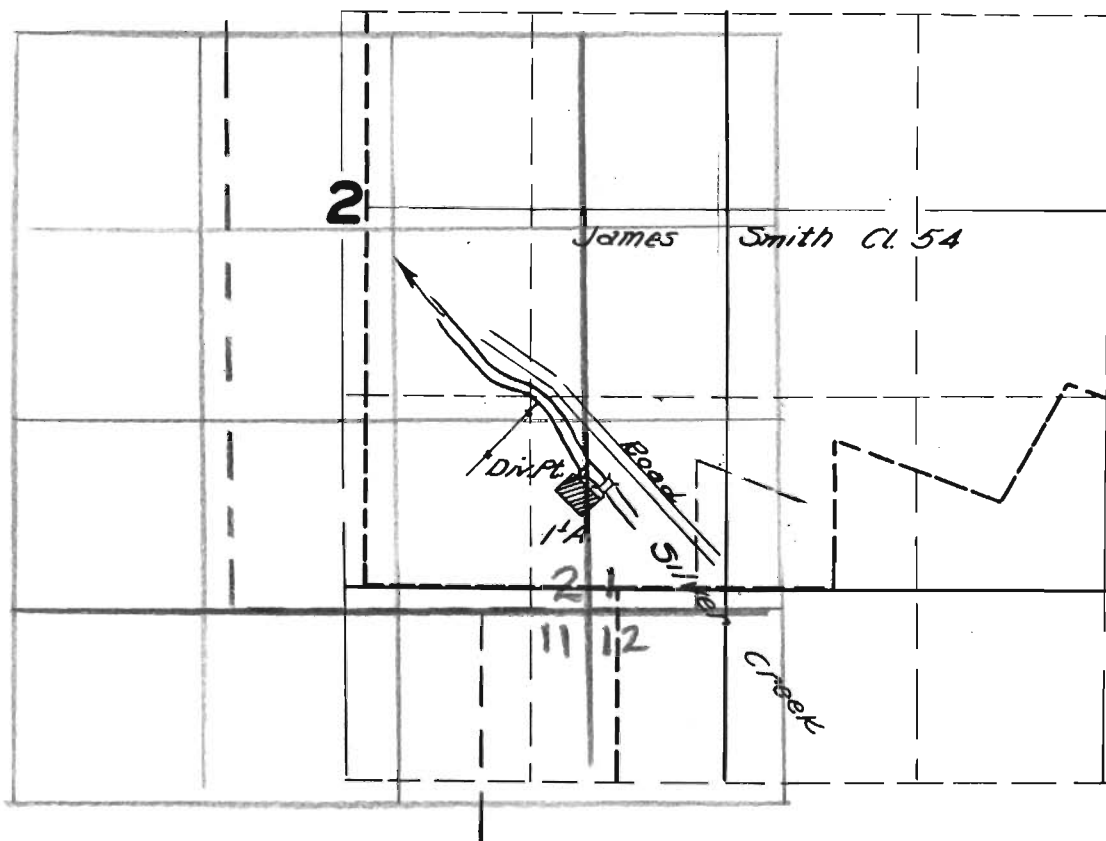

Section lines  
and 40 lines  
should be about  
as shown in  
red.

Error in "tie"  
Needs to be  
Redrafted?  
7/20/84  
WME

**FINAL PROOF SURVEY**

UNDER

Application No. 22387. Permit No. 17648.

IN NAME OF

..... ROY C. GOSSO .....

Surveyed AUG. 28. 1950., by H.L. COFFMAN.