


# T.5S.R.5W.W.M.

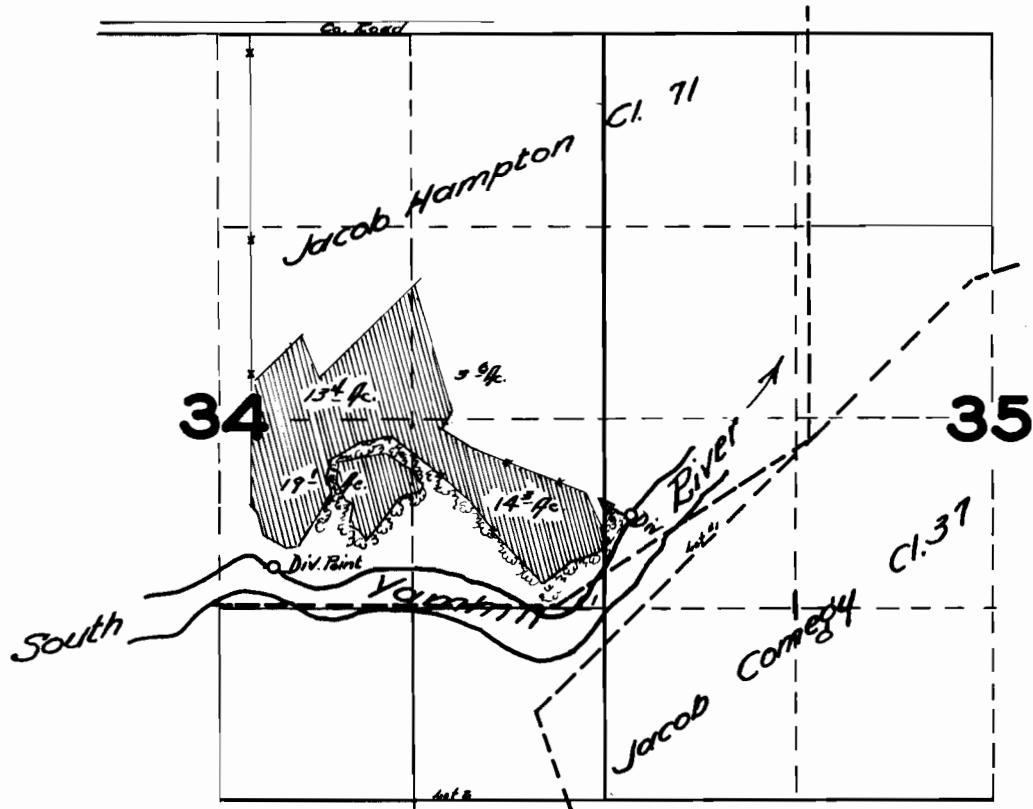

## FINAL PROOF SURVEY

UNDER

Application No. 22456 Permit No. 17684

IN NAME OF

HARRY CROWE

Surveyed 9/28 1951, by H.L. COFFMAN