


T.1S.R.3W.W.M.

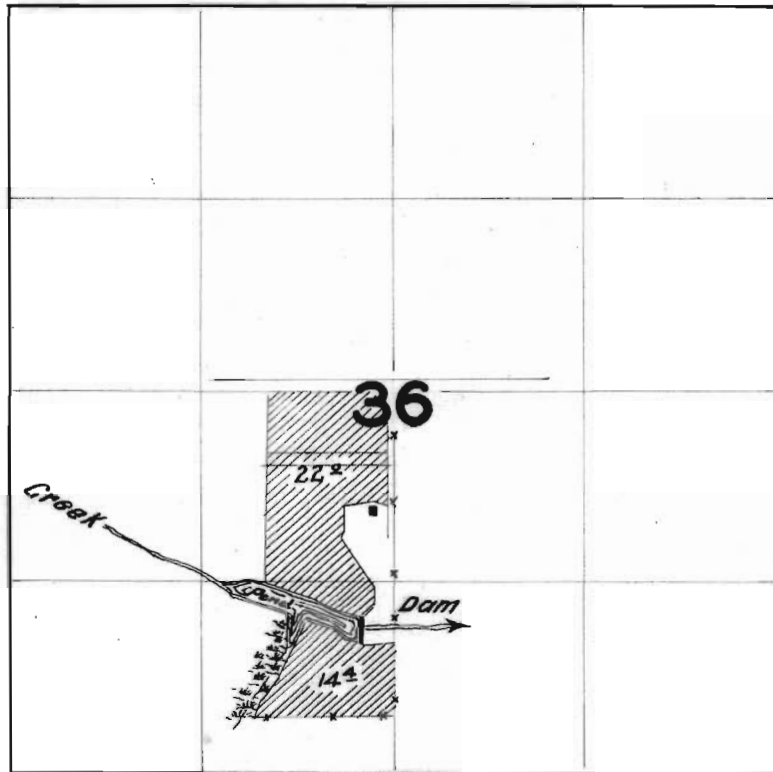

FINAL PROOF SURVEY
UNDER

Application No. 22490 Permit No. 17730
IN NAME OF

..... JOSEPH W. TWIGG

Surveyed 7/30 1951, by H.L. COFFMAN