


T. I. S. R. I W. W. M.

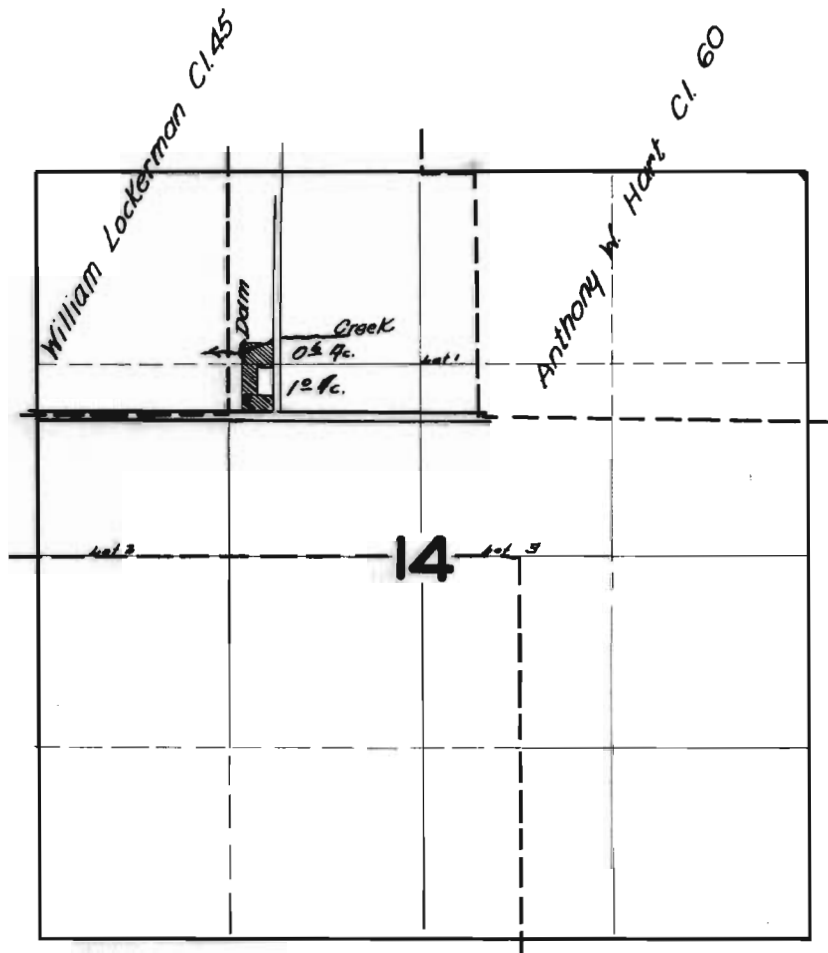

FINAL PROOF SURVEY

UNDER

Application No. 22527 Permit No. 17746

IN NAME OF

B. E. TORPEN

Surveyed JUNE 26 1951, by H. L. COFFMAN