


T.I.S.R.38E.W.M.

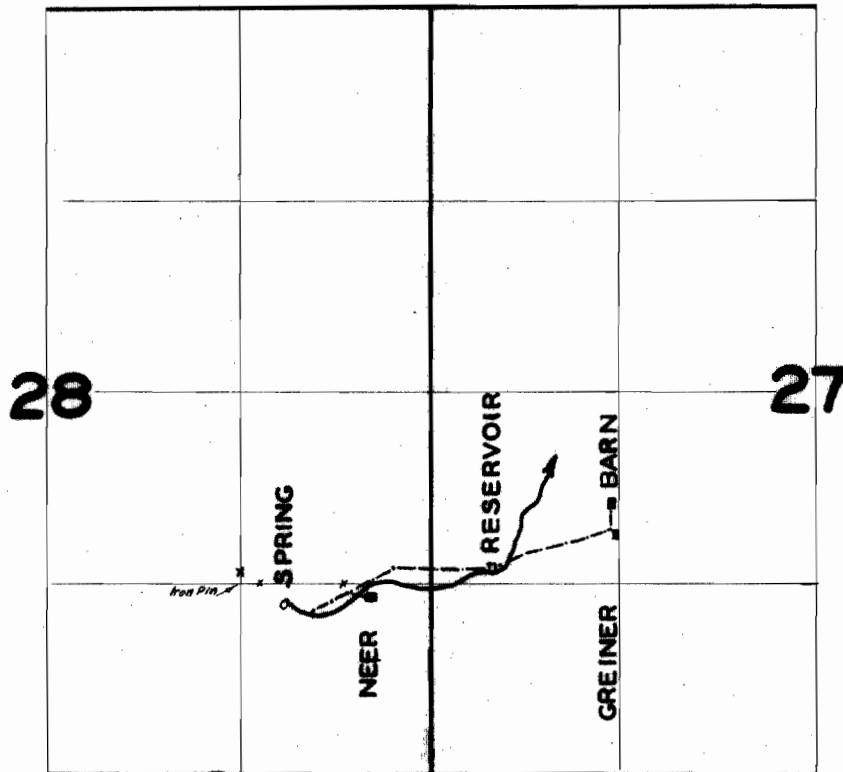

FINAL PROOF SURVEY
UNDER

Application No. 22534 Permit No. 17749
IN NAME OF

..... R.A. & B.A. GREINER

Surveyed 10/25 1951, by H.L. COFFMAN