


# T.5 S.R.7W.W.M.

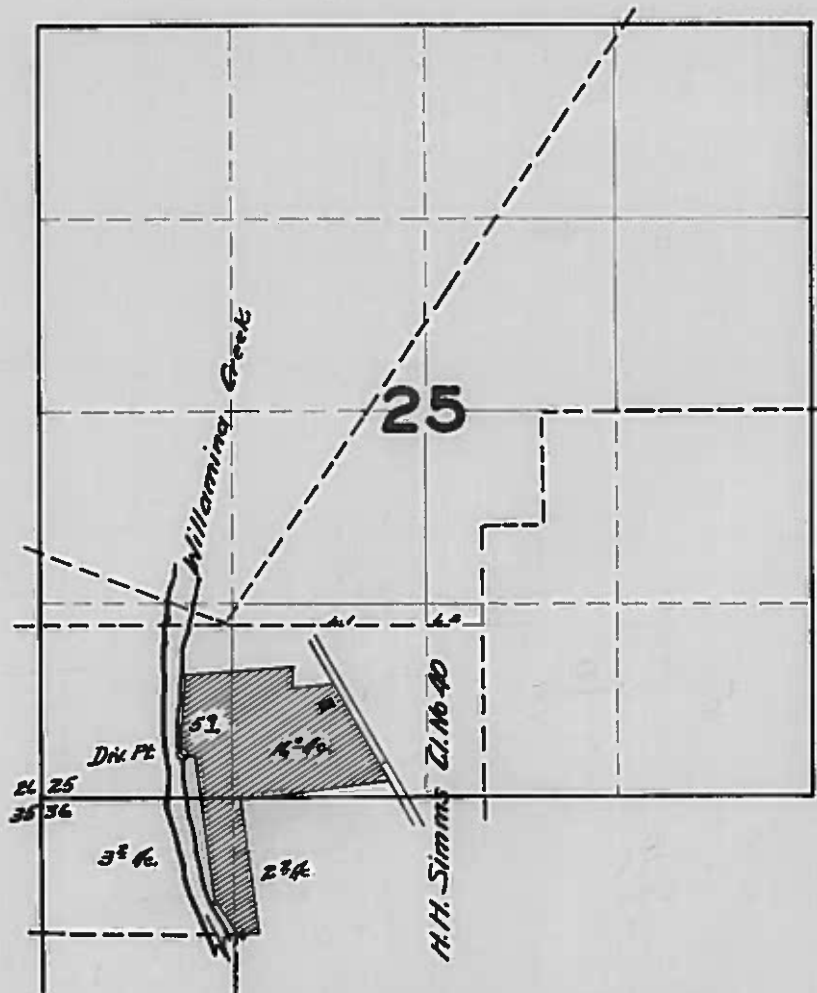

## FINAL PROOF SURVEY

UNDER

Application No. 22845 Permit No. 17967

IN NAME OF

VERNON D. RIGGLE

Surveyed 10/2, 1951, by H. L. COFFMAN