


T. I. N. R. | W. W. M.

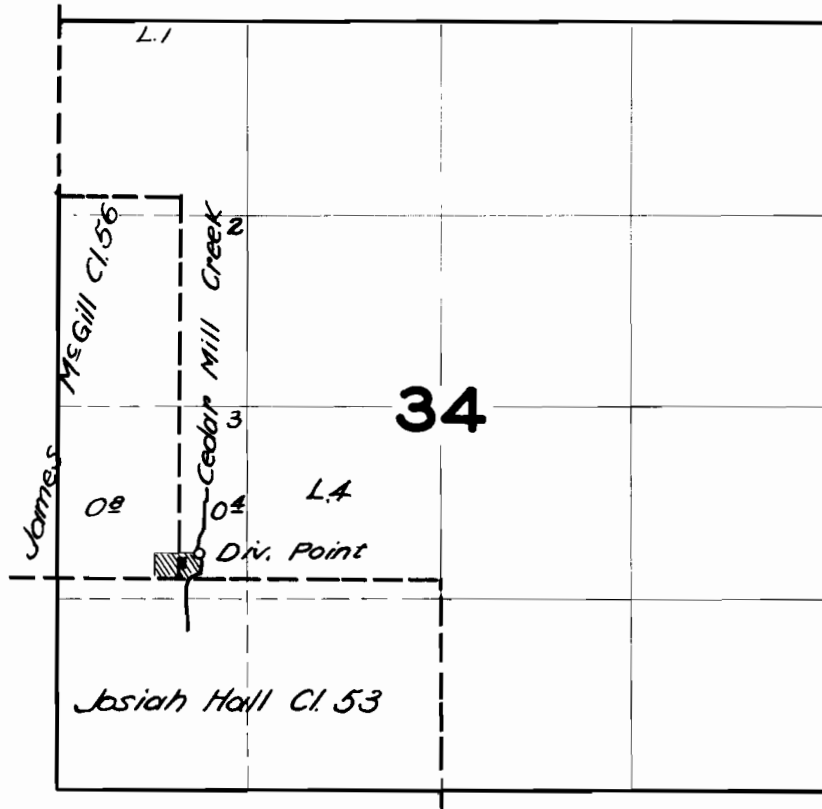

FINAL PROOF SURVEY

UNDER

Application No. 22715 Farm. No. 17927

IN NAME OF

GEORGE E. COTE

Surveyed 6/28 1951, by H.L. COFFMAN.