


# T.5S.R.5W.W.M.

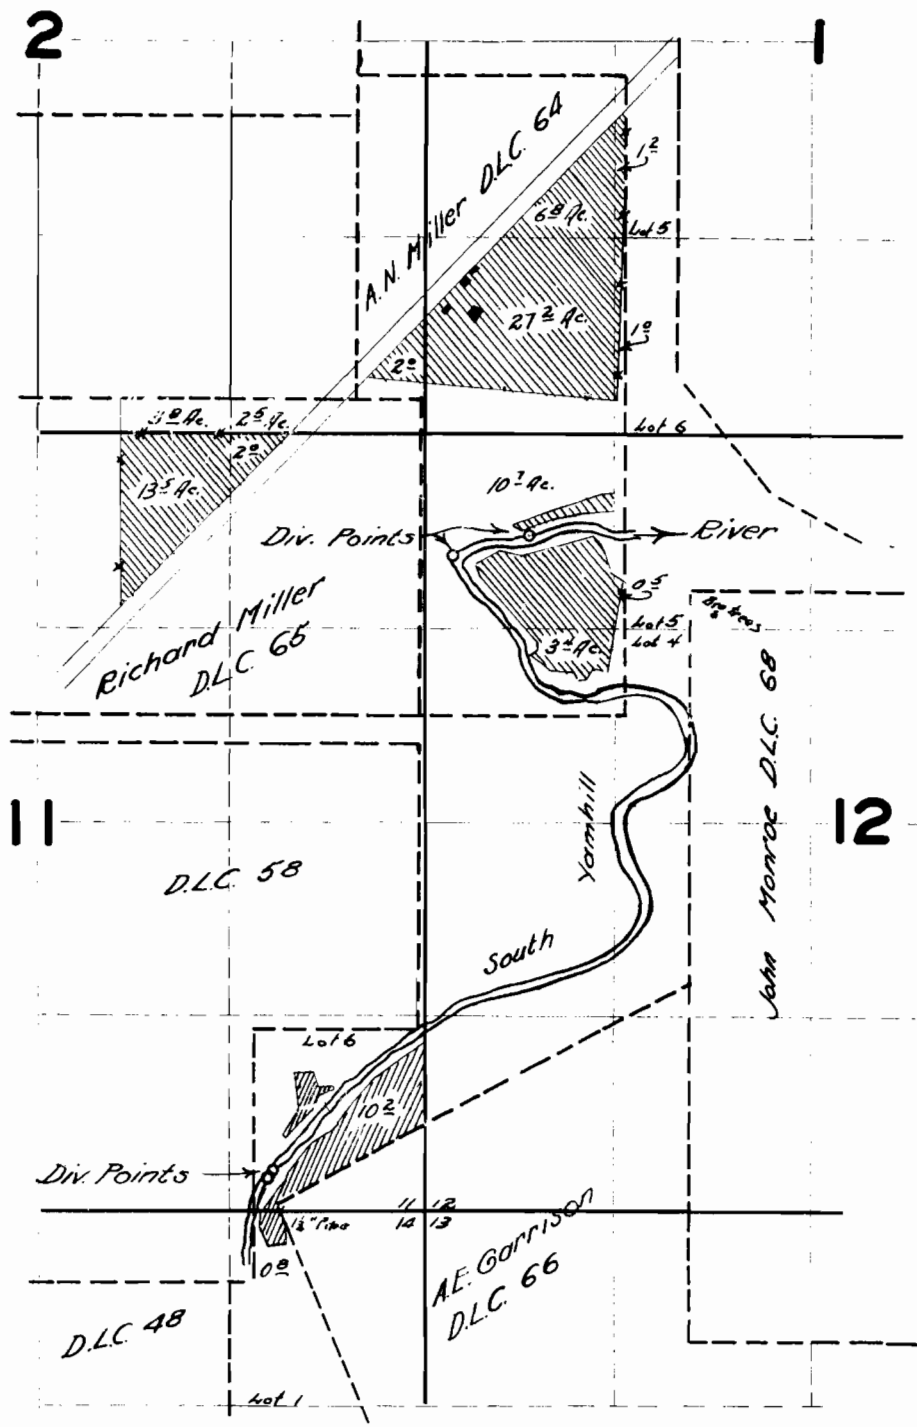

17643  
23025

13340  
18196

CHESTER L. MULKEY

9/17 51 H.L. COFFMAN