


**T.2S.R.3W.W.M.**

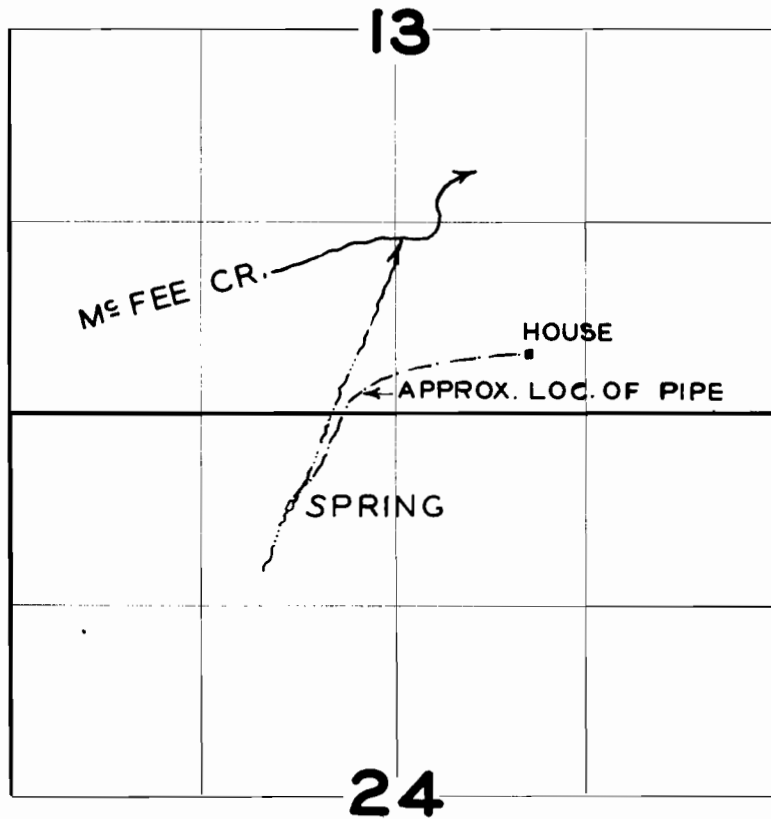

**FINAL PROOF SURVEY**  
UNDER

Application No. 23057... Permit No. 18552..  
IN NAME OF

..... JAMES D. JOHNSON .....

Surveyed JUNE 7, 1951., by H.L. COFFMAN