


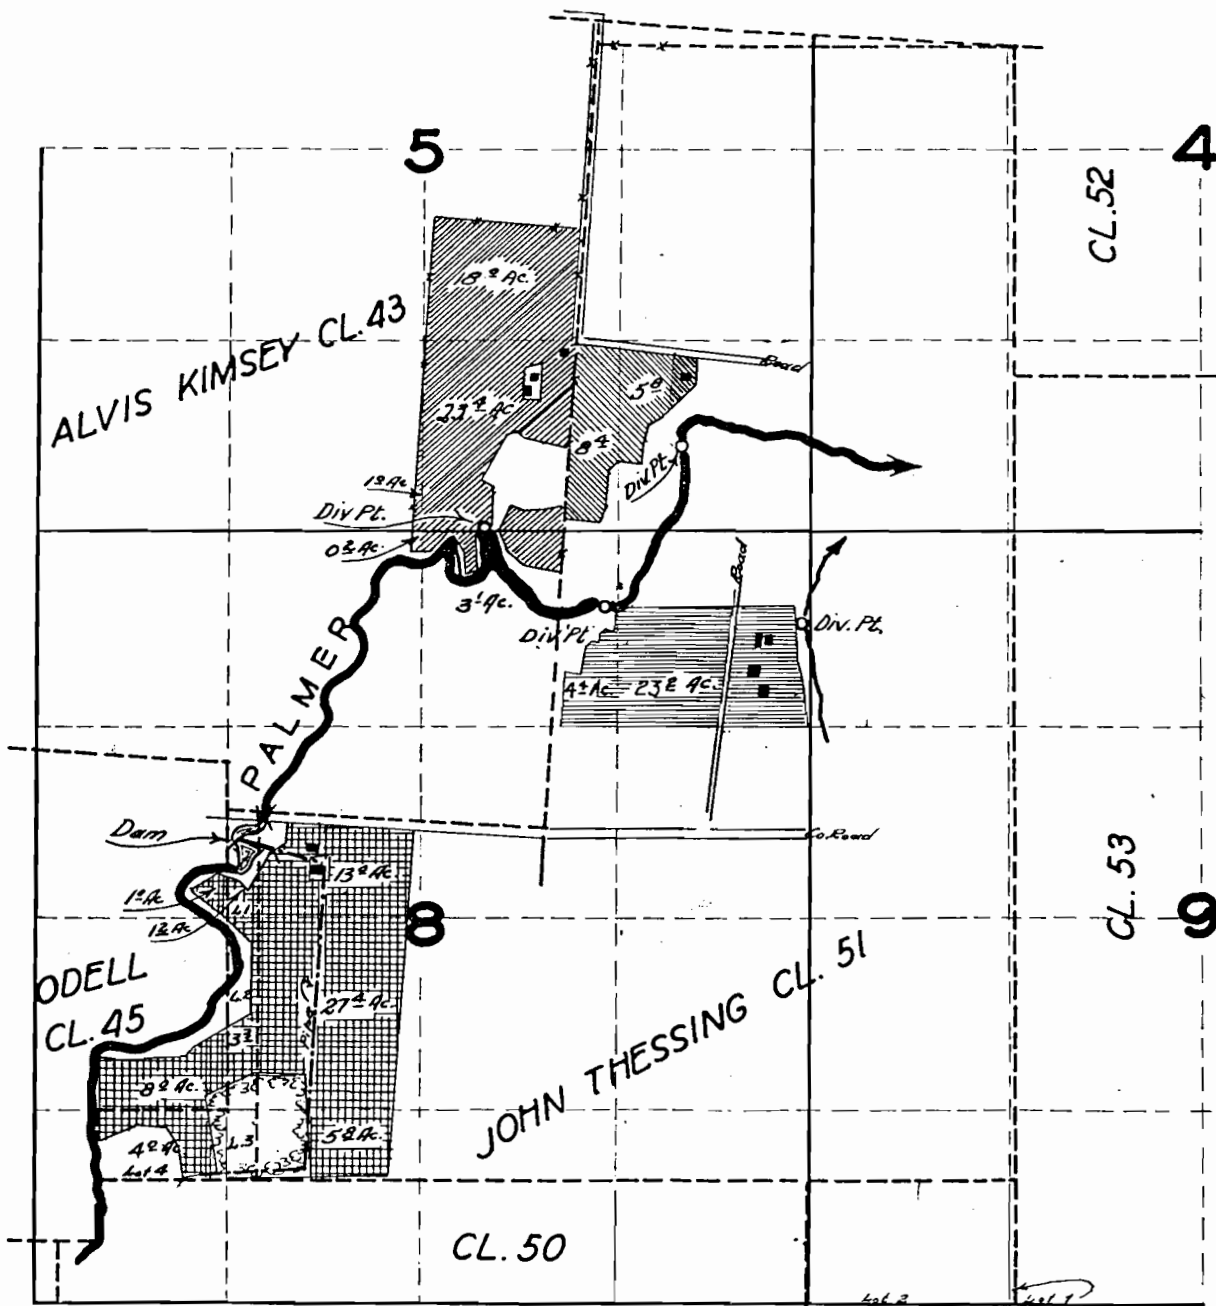



# T.5S. R.3W.W.M.



## FINAL PROOF SURVEY

P. N. & E.B. EDIGER	APP. 21812	PER. 17162	
BRUCE V. MILLAM	APP. 23251	PER. 18352	
J.V. DOWNEY	APP. 22536	PER. 18019	
J. W. RICHARDSON	APP. 16277	PER. 12155	
SURVEYED 9/10 1951			H.L. COEFMAN