


T.21S.R.3W.W.M.

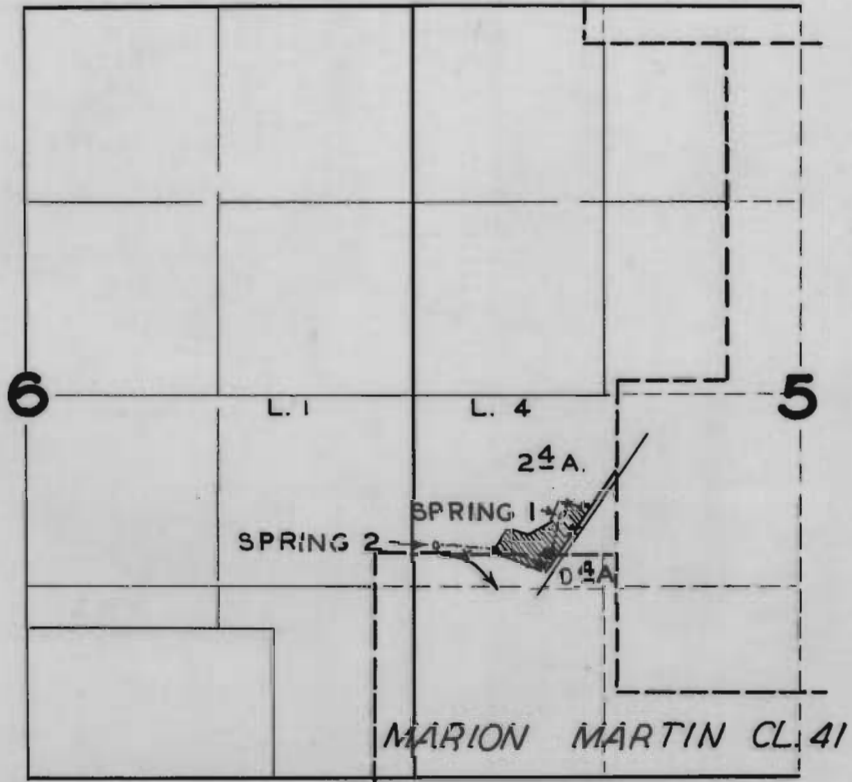

FINAL PROOF SURVEY UNDER

Application No. 23289 Permit No. JB.372
IN NAME OF

ZELMA L. & WILL C. NORWOOD

Surveyed MAY 31 1950, by H. L. COFFMAN