


T.20S. R.3W.W.M.

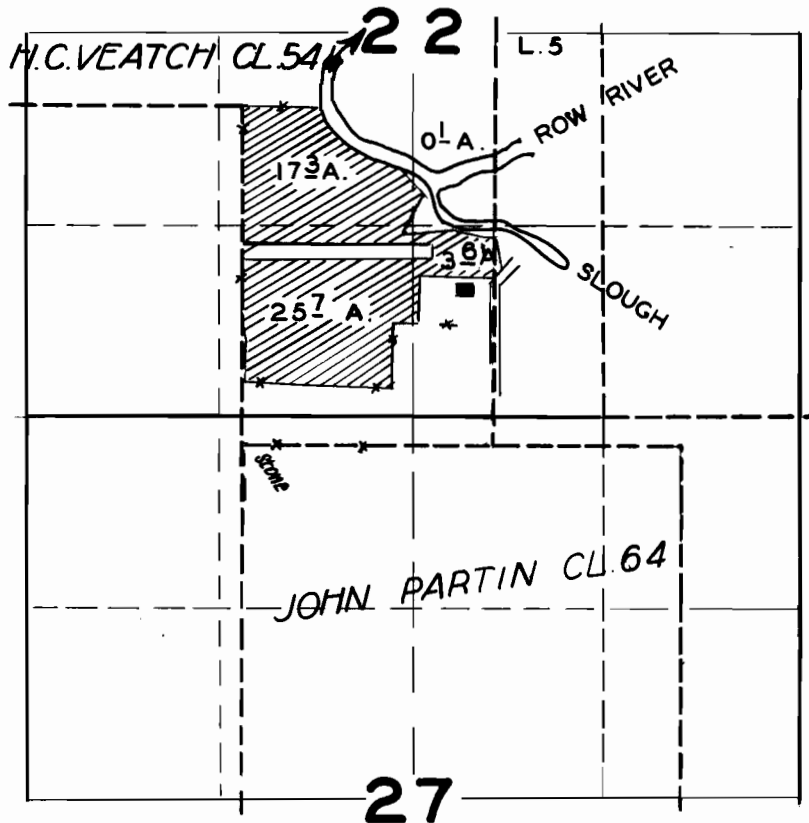

FINAL PROOF SURVEY
UNDER

Application No. 23335. Permit No. 18443.
IN NAME OF

MARGARET L. HEMENWAY

Surveyed MAY 2, 1951, by H.L. COFFMAN