


T. 1 S.R. 2W.W.M.

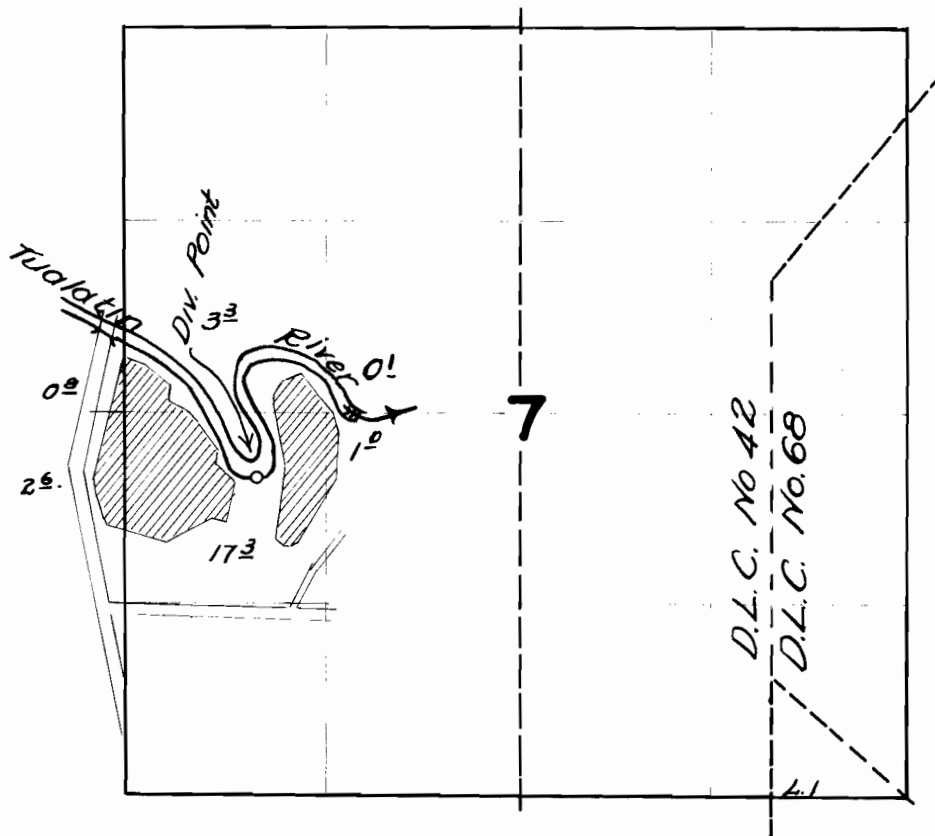

FINAL PROOF SURVEY UNDER

Application No. 23421 Permit No. 18489
IN NAME OF

CARL E. PIERSON

Surveyed 7/13 1951, by H.L. COFFMAN