


T.2S. R. 2W.W.M.

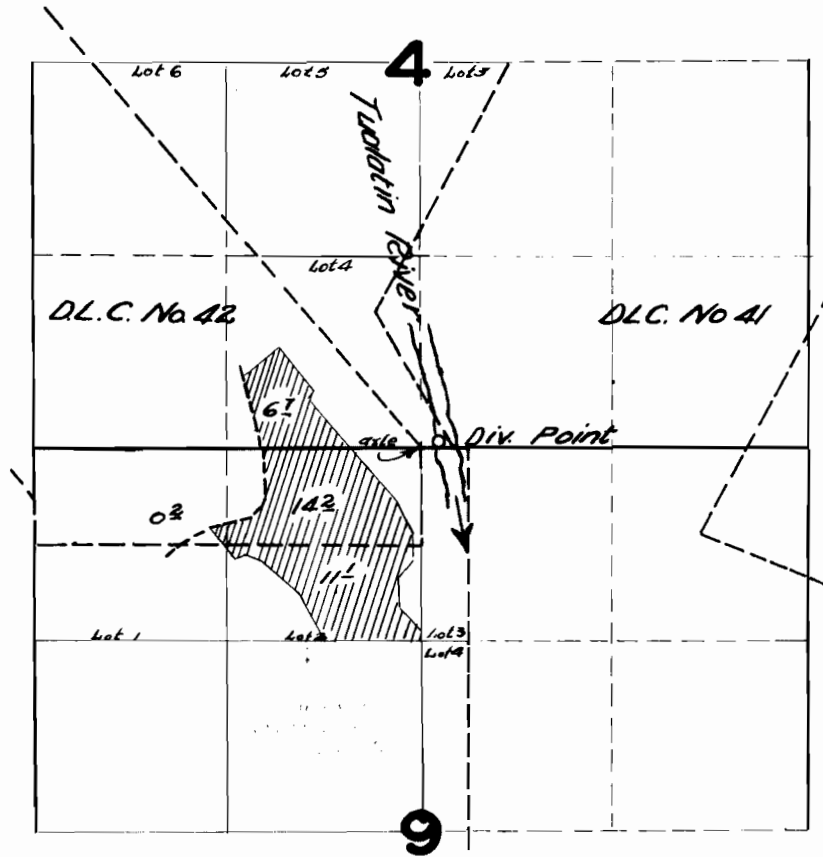

FINAL PROOF SURVEY UNDER

Application No. 23678. Permit No. 18663.
IN NAME OF

..... EDWARD M. McCALLEN

Surveyed 7/31 1951, by H.L. COFFMAN.