


T.10S. R.1 & 2 W.W.M.

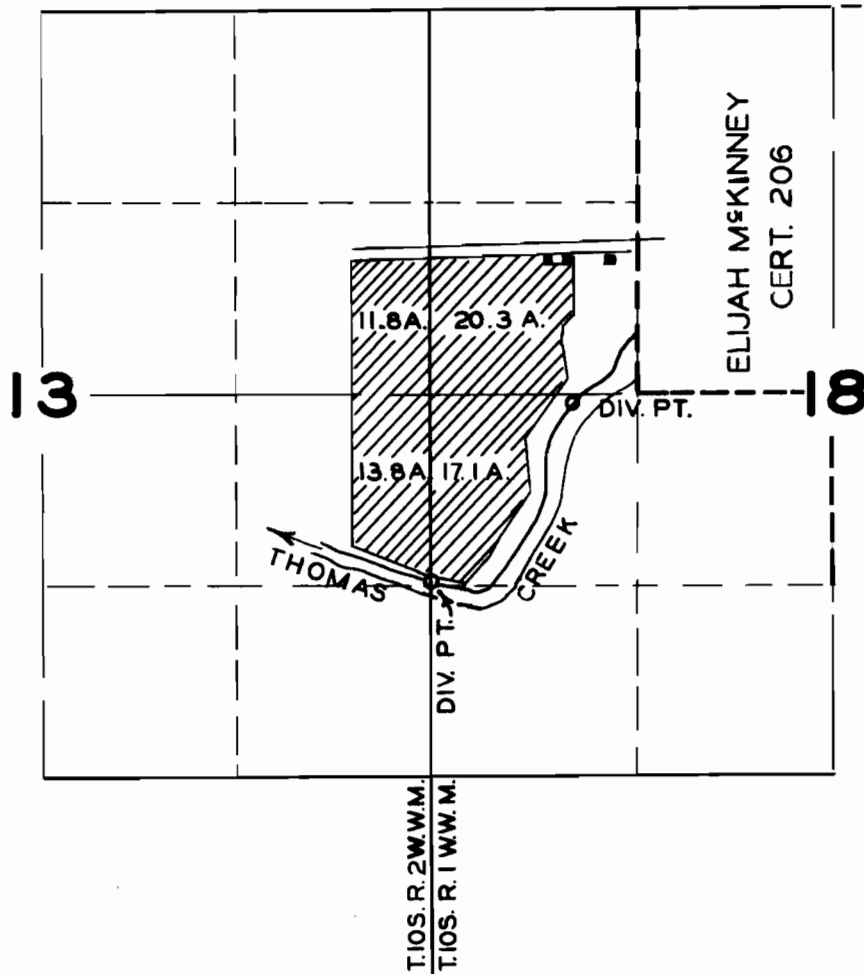

FINAL PROOF SURVEY

UNDER

Application No. **23917** Permit No. **18839**

IN NAME OF

FRED & EVELYN ROBINSON

Surveyed APR. 10, 1951, by H.L. COFFMAN