


T. 1 N. R. 3 W. W. M.

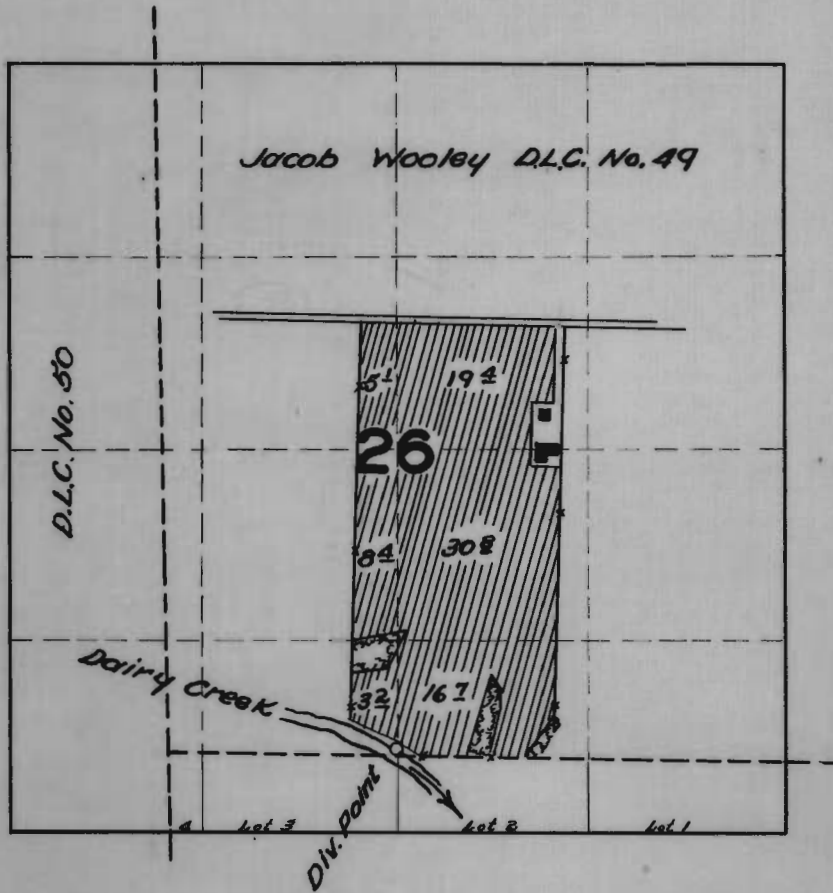

FINAL PROOF SURVEY

UNDER

Application No. 23528 Permit No. 18583.
IN NAME OF

..... FRED SCHELLER

Surveyed 8/1 1951, by H.L. COFFMAN.