


T.3S.R.3W.W.M.

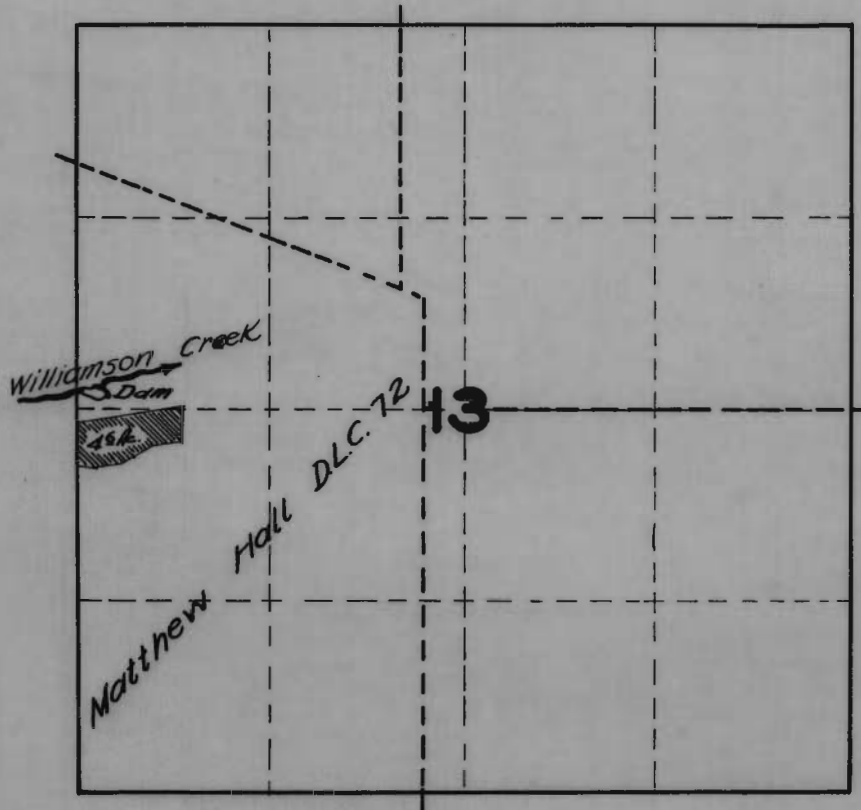

FINAL PROOF SURVEY

UNDER

Application No. 23641... Permit No. 18647...

IN NAME OF

DELMER HALL

Surveyed OCT. 11, 1951, by H.L. COFFMAN.