


T. 3 S. R. 4 W. W. M.

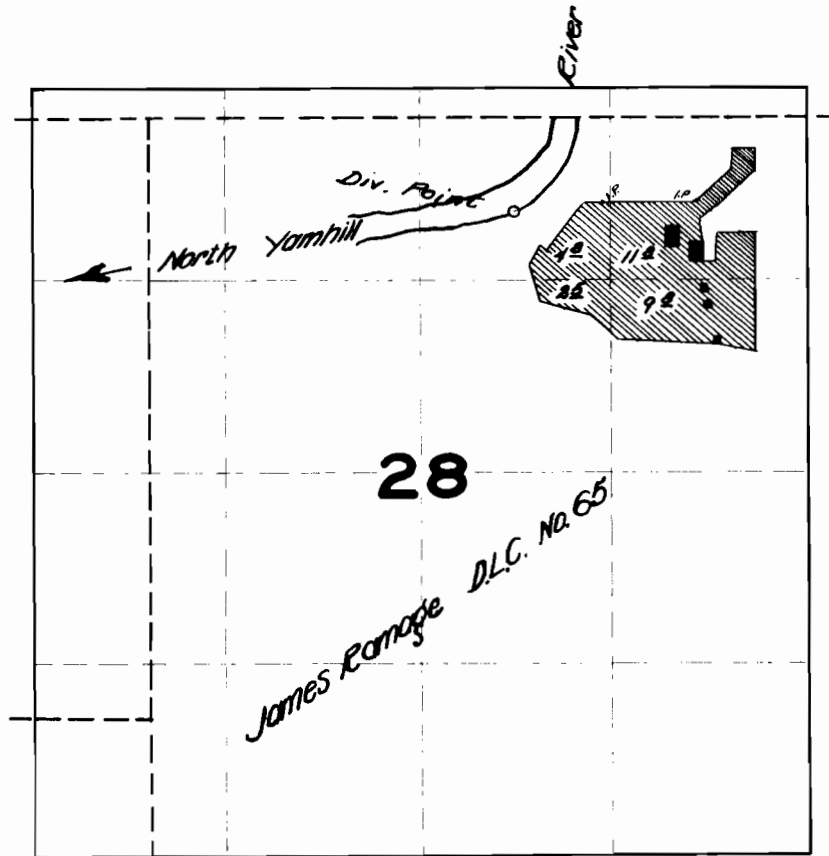

FINAL PROOF SURVEY

UNDER

Application No. 23983. Permit No. 18922
IN NAME OF

E. J. LINKE

Surveyed 10/10/1951, by H. L. COFFMAN...