


# T. 11 S. R. 2 W. W. M.

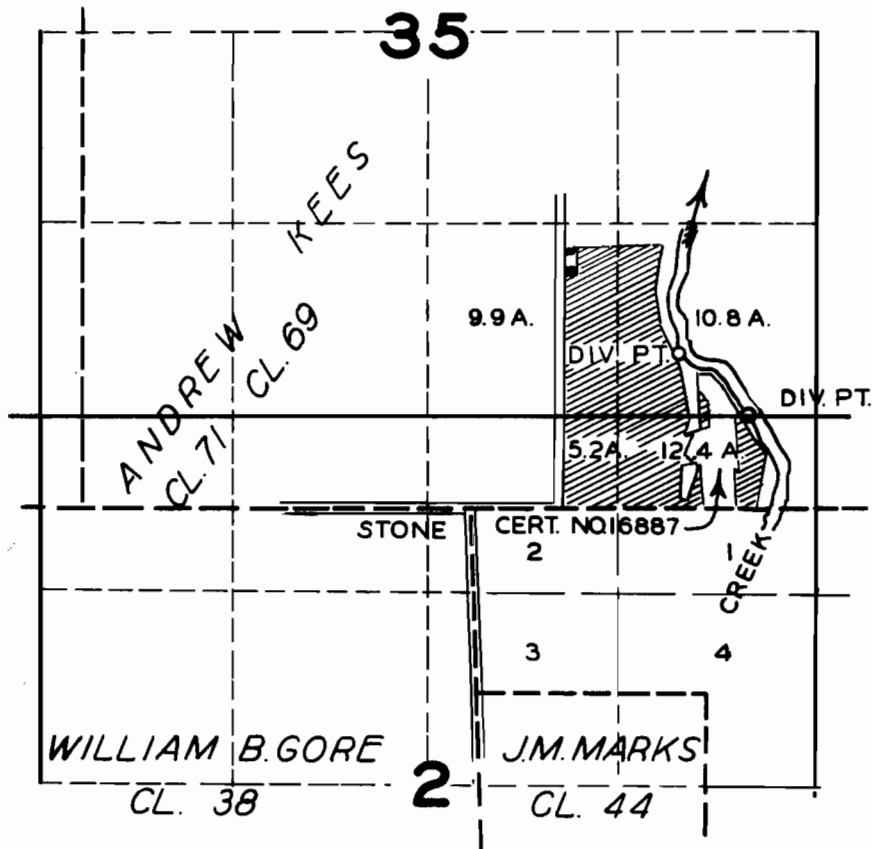

## FINAL PROOF SURVEY UNDER

Application No. 23651... Permit No. 18698...  
IN NAME OF

G. COWGILL

Surveyed APR. 20, 1951, by H.L. COFFMAN