


# T.5S.R.4W.W.M.

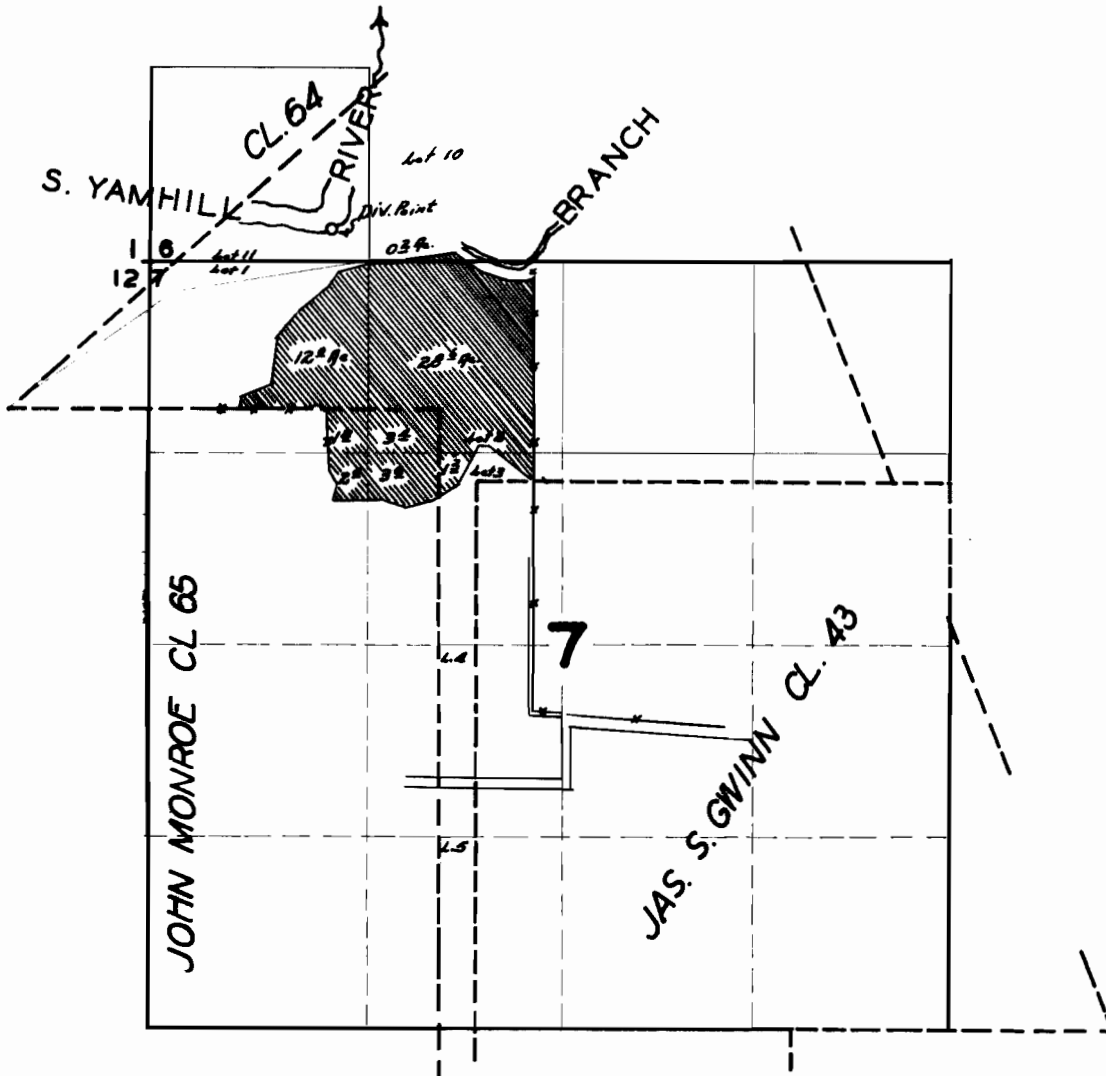

## FINAL PROOF SURVEY

UNDER

Application No. 23812 Permit No. 19093

IN NAME OF

W. S. TURLEY

Surveyed 9/12 1951, by H.L. COFFMAN