


# T I S. R. I W. W. M.

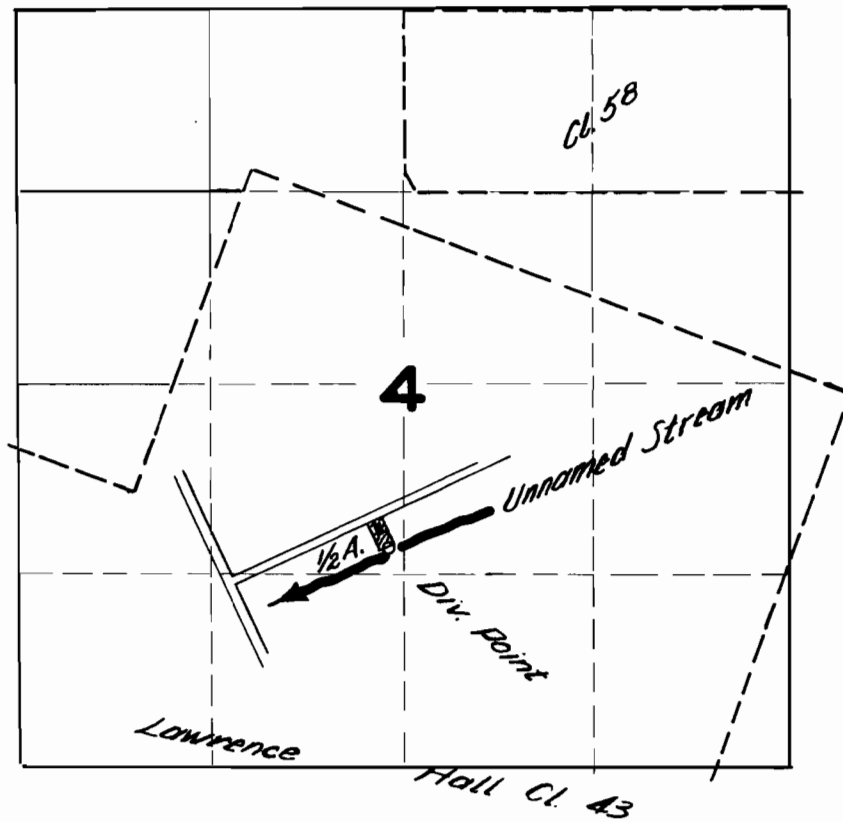

## FINAL PROOF SURVEY

UNDER

Application No. 24305 Permit No. 19125

IN NAME OF

T. J. MORRIS

Surveyed 6/27 1951, by H.L. COFFMAN