


T.I.S. R.I.W.W.M.

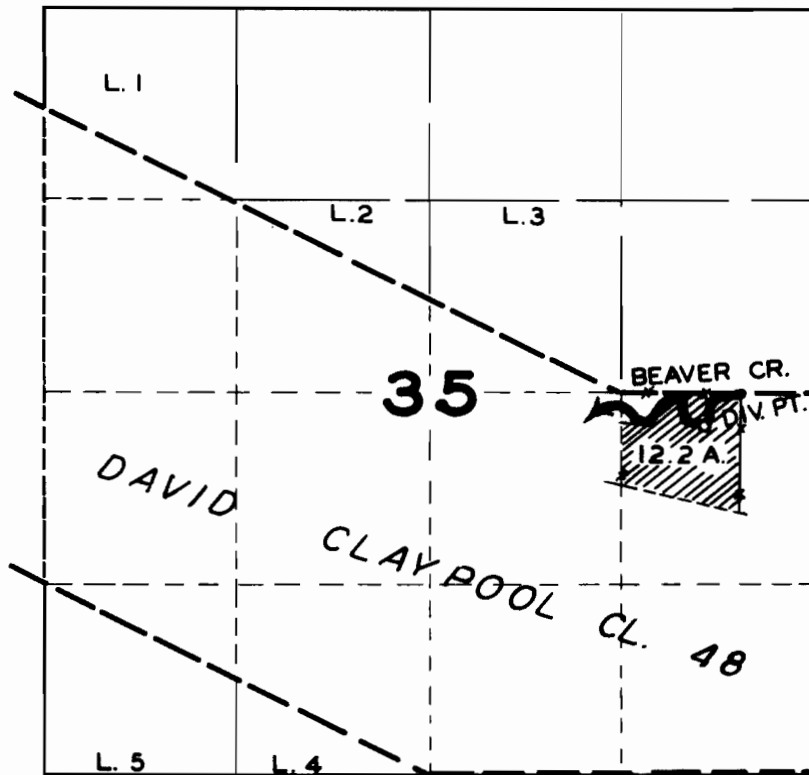

FINAL PROOF SURVEY UNDER

Application No. 23836 Permit No. 18779
IN NAME OF

L. L. LUCKINI

Surveyed APR. 19 1951, by H. L. COFFMAN