


T.3S.R.4W.W.M.

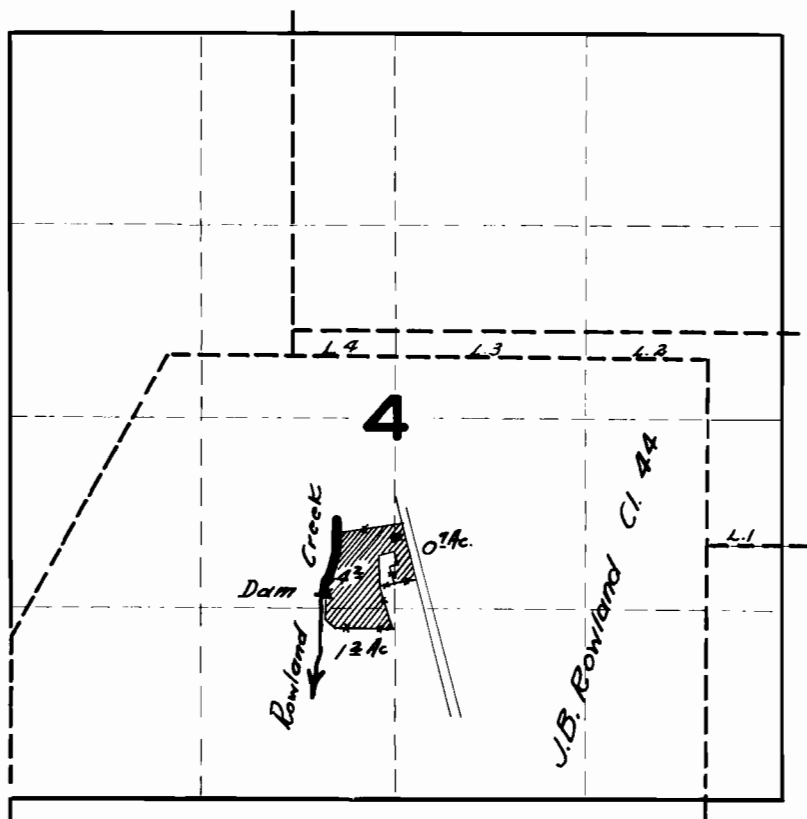

FINAL PROOF SURVEY

UNDER

Application No. 24414 Permit No. 19254.

IN NAME OF

R. J. & MABEL WULF

Surveyed 10 / 9 ... 1951., by H.L. COFFMAN