


T.6S.R.7W.W.M.

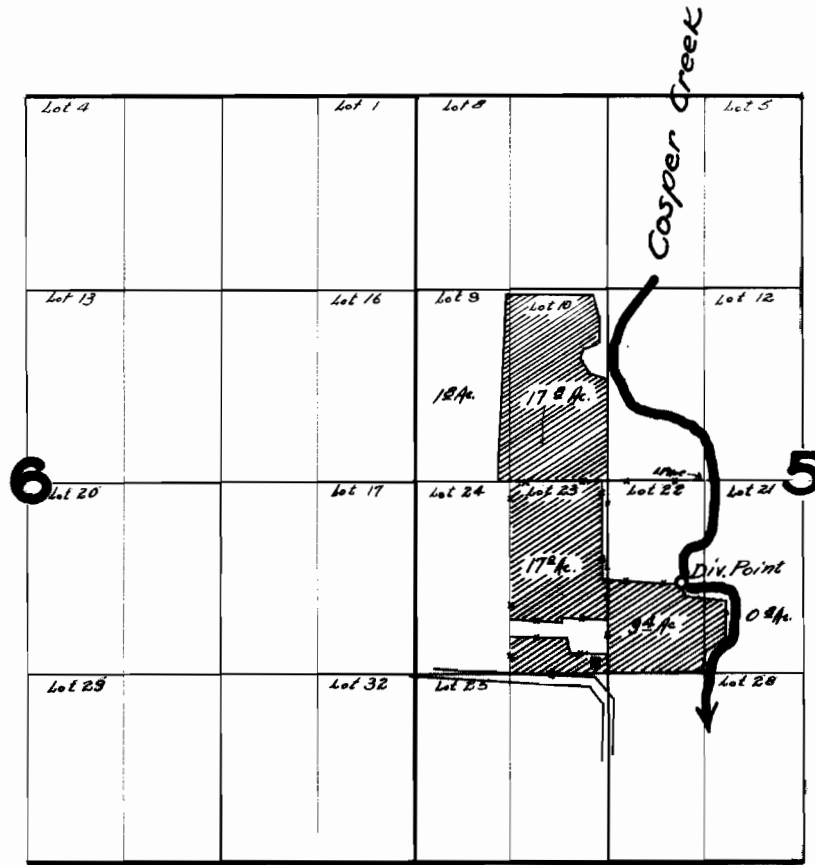

FINAL PROOF SURVEY
UNDER

Application No. 23942 Permit No. 18905
IN NAME OF

ABNER COBLENTZ

Surveyed OCT. 12 1951, by H.L. COFFMAN