


3.

[illegible]

3. S.

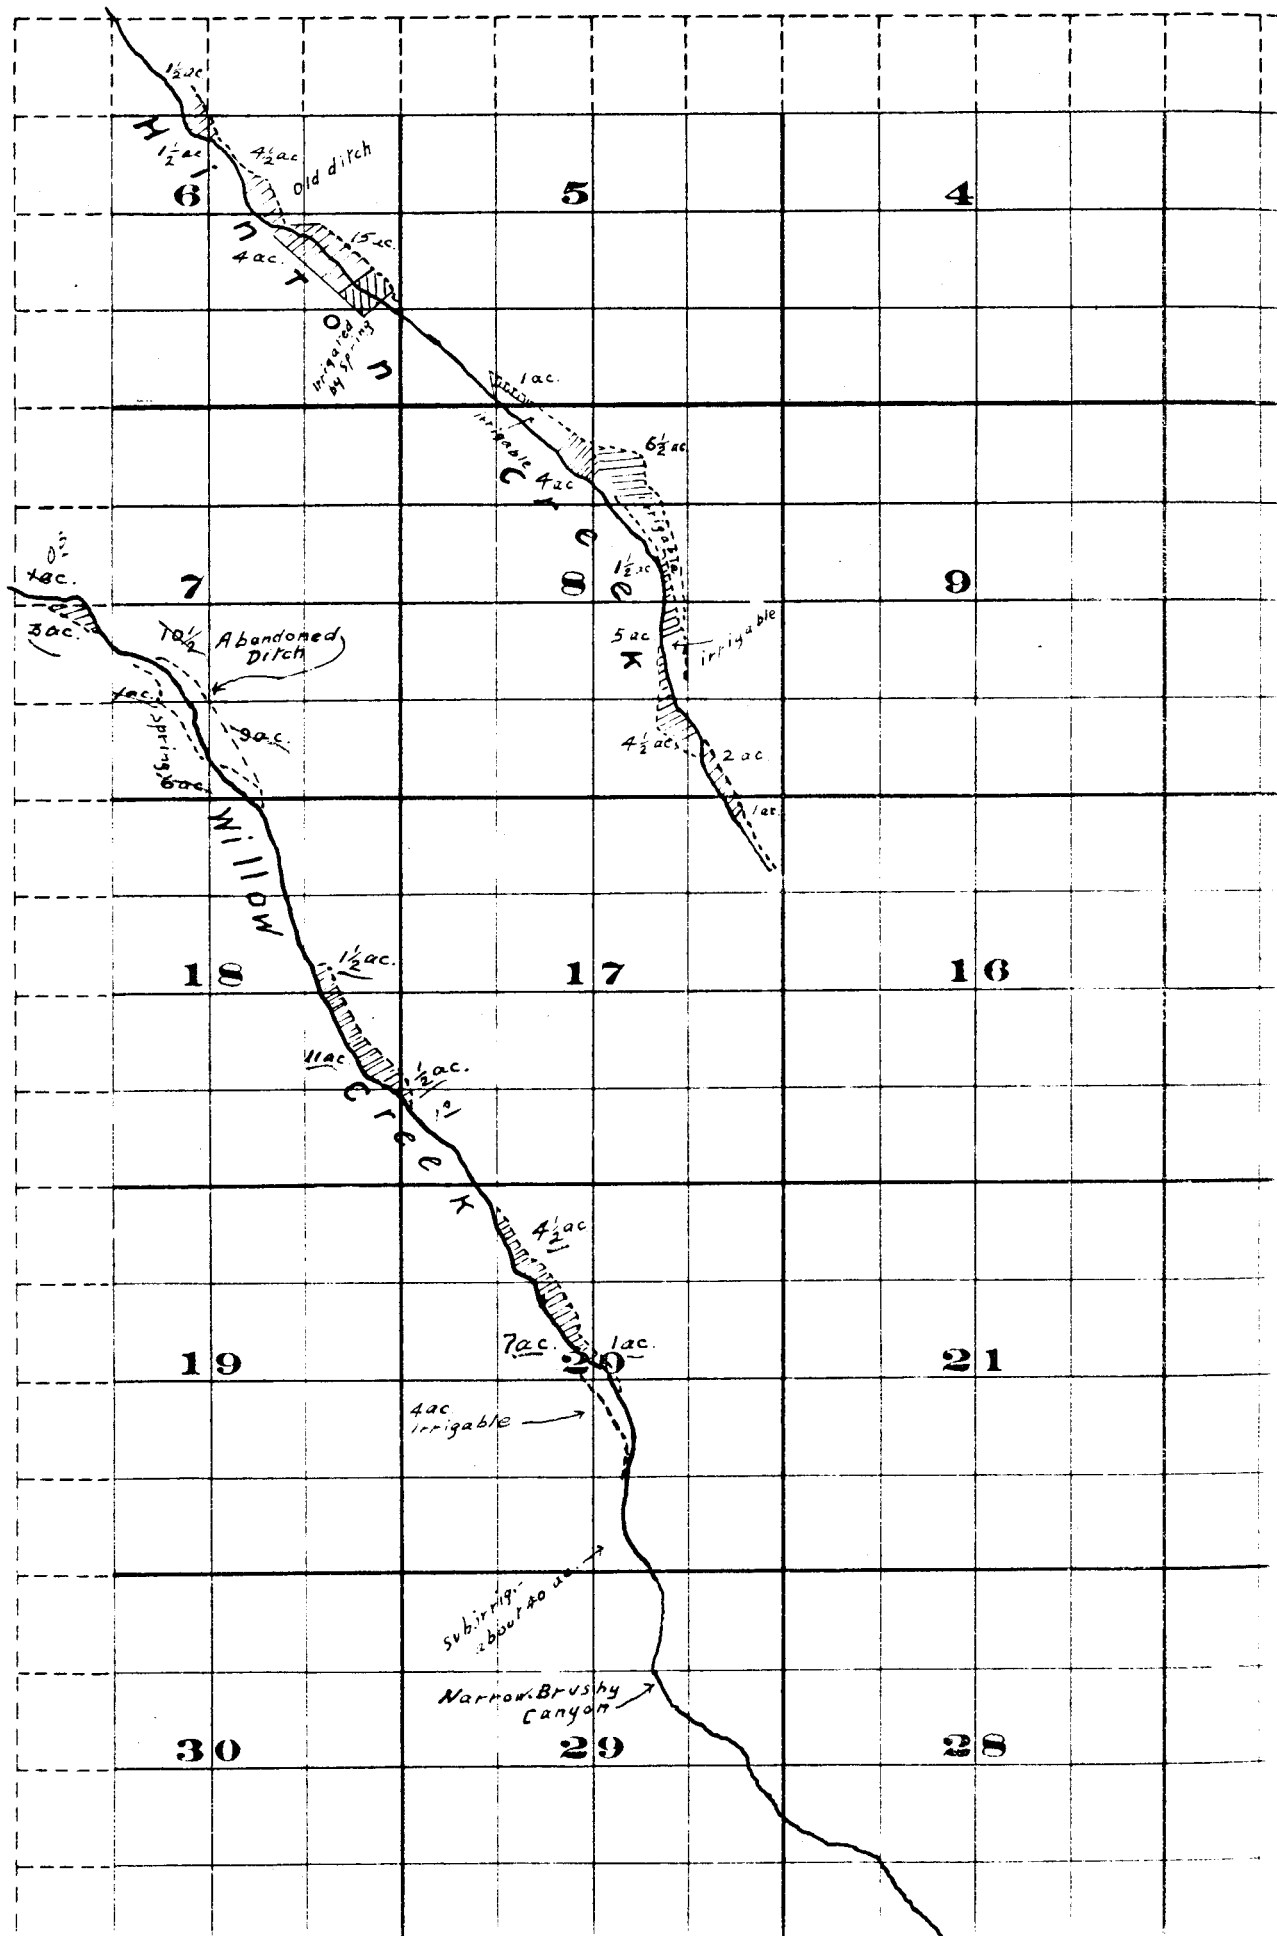

15			14				13		
22			23				24		
27			26				25		
34			35				36		

FROM OFFICE OF THE STATE ENGINEER, SALEM, OREGON

Willow Creek Adjudication.

35.28 E.