


T2S.R.38E.W.M.

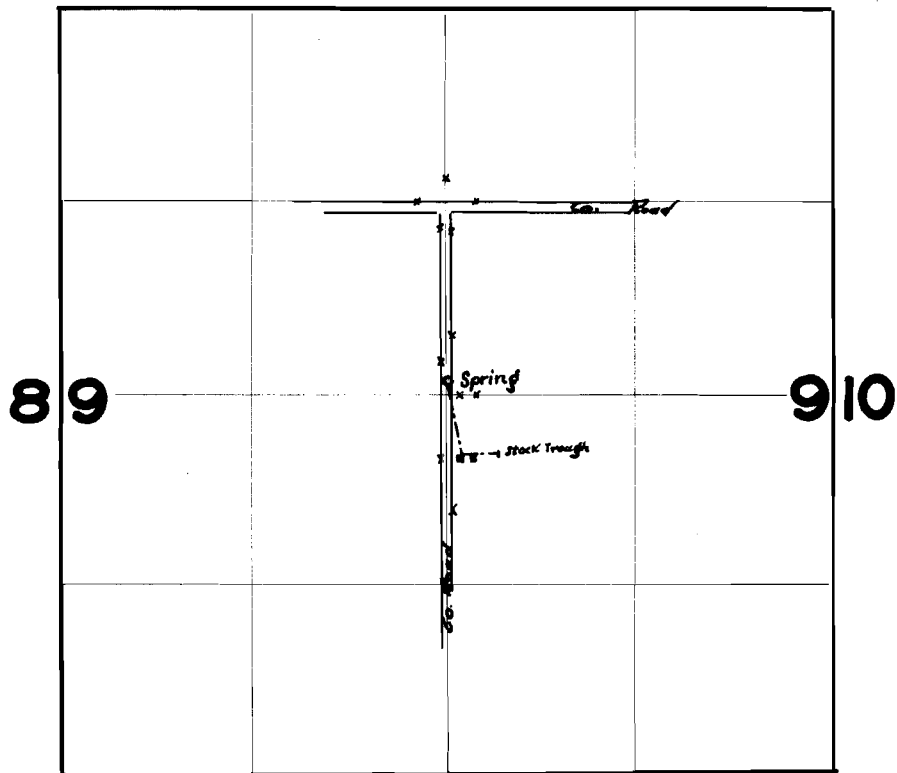

FINAL PROOF SURVEY
UNDER

Application No. 24024 Permit No. 19191.....
IN NAME OF

WILEY M. NEBEKER

Surveyed 10/24 1951, by H.L. COFFMAN.