


T.3S.R.38E.W.M.

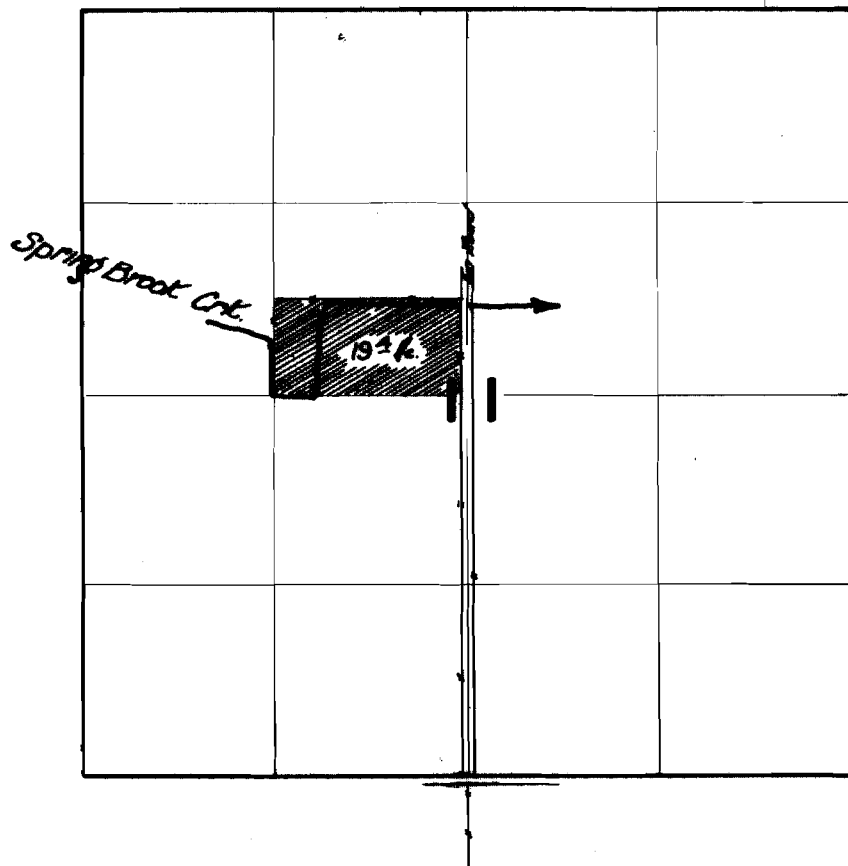

FINAL PROOF SURVEY
UNDER

Application No. 24078 Permit No. 18963
IN NAME OF

C. V. & LEWA AGER

Surveyed 10/24 1951, by H. L. COFFMAN