


T.14 S.R.1 W.W.M.

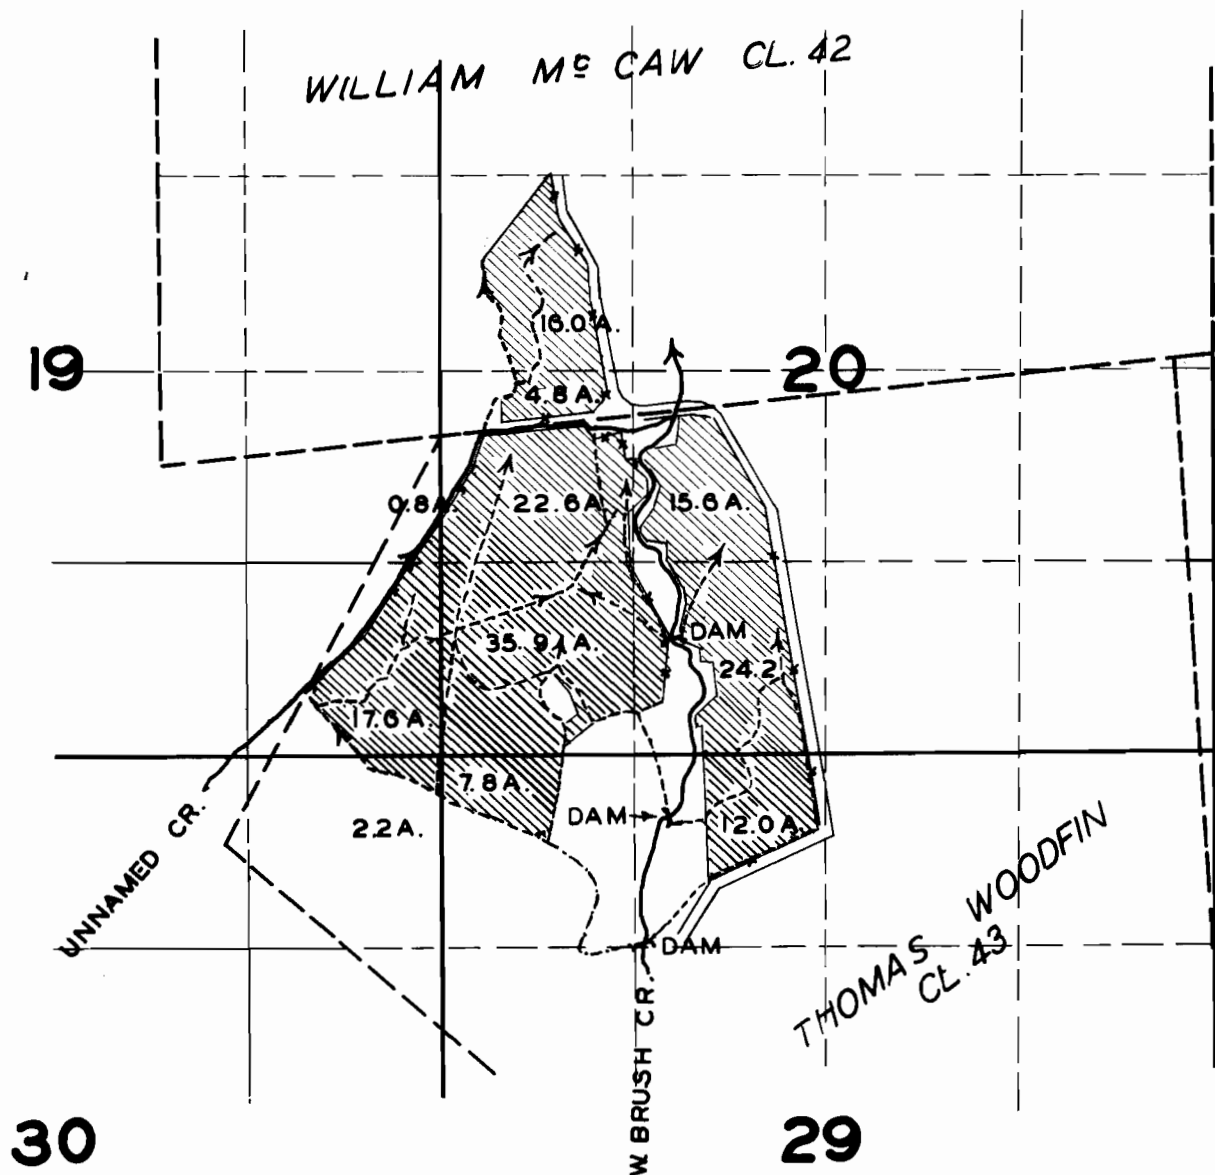

FINAL PROOF SURVEY
UNDER

Application No. 15792... Permit No. 11762..
IN NAME OF

PRESTON BURLINGHAM & LUTHER WALLACE, JR.

Surveyed APR. 26, 1951., by H.L. COFFMAN