

SECTION

#61


D. E. Millard (61) Ass
John Bochar P. 18971
Application
Permit No. 18971
Priority - Sept. 8, 1949

TOWNSHIP 36S, RANGE 3N, W. M.

Cent. 19903

North

Find in Rogue River, Vol. 1

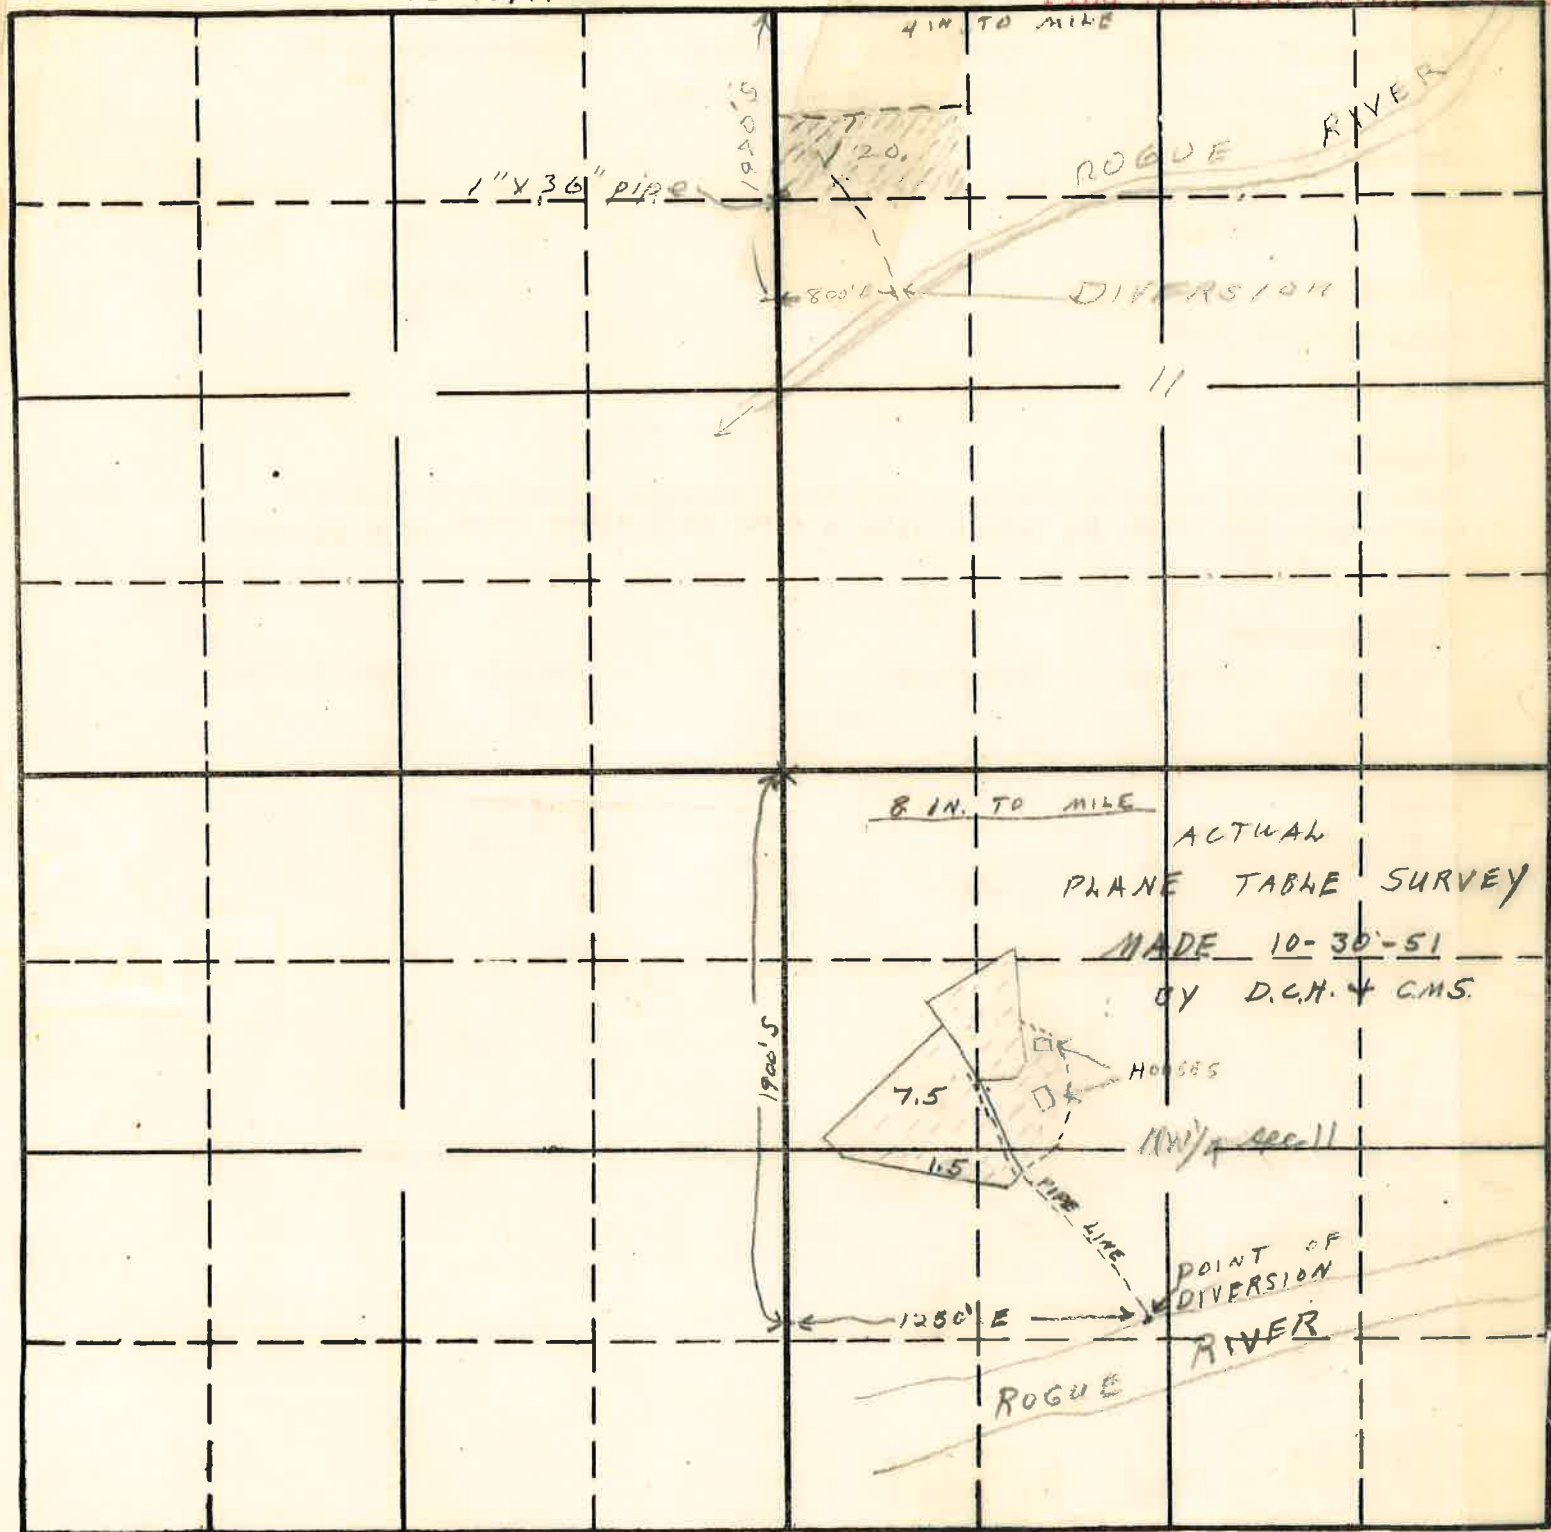

D. E. Millard for use of water
in Rogue River for irrigation

South

APPLICATION No.
PERMIT No.