


# T.1N.R.39E.W.M.

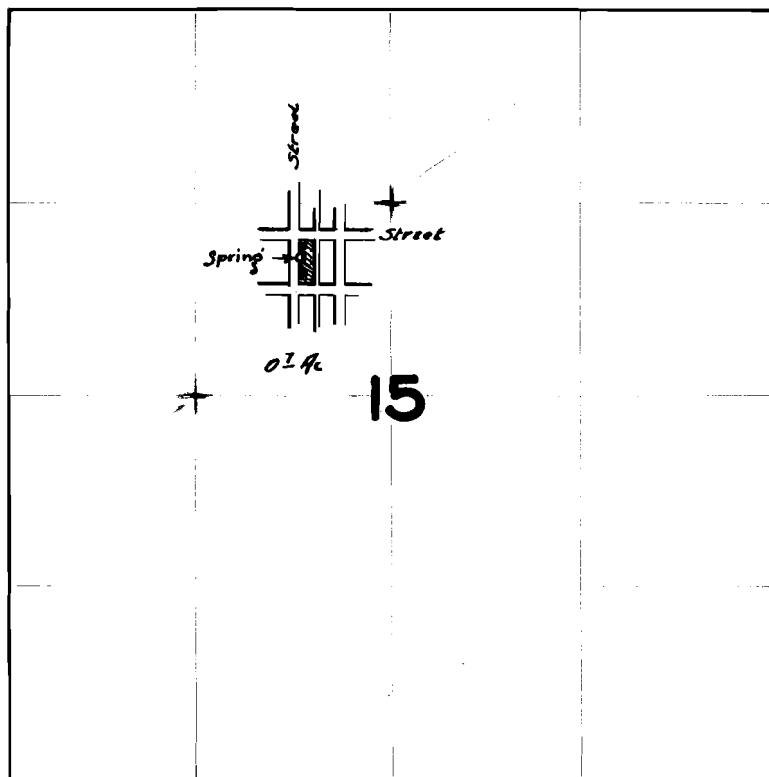

## FINAL PROOF SURVEY

UNDER

Application No. 24228 Permit No. 19034..

IN NAME OF

.....OLLIE V. BRIGGS.....

Surveyed 10 / 23 .. 1951 .., by HL. COFFMAN.....