


T.3 S.R.40E.W.M.

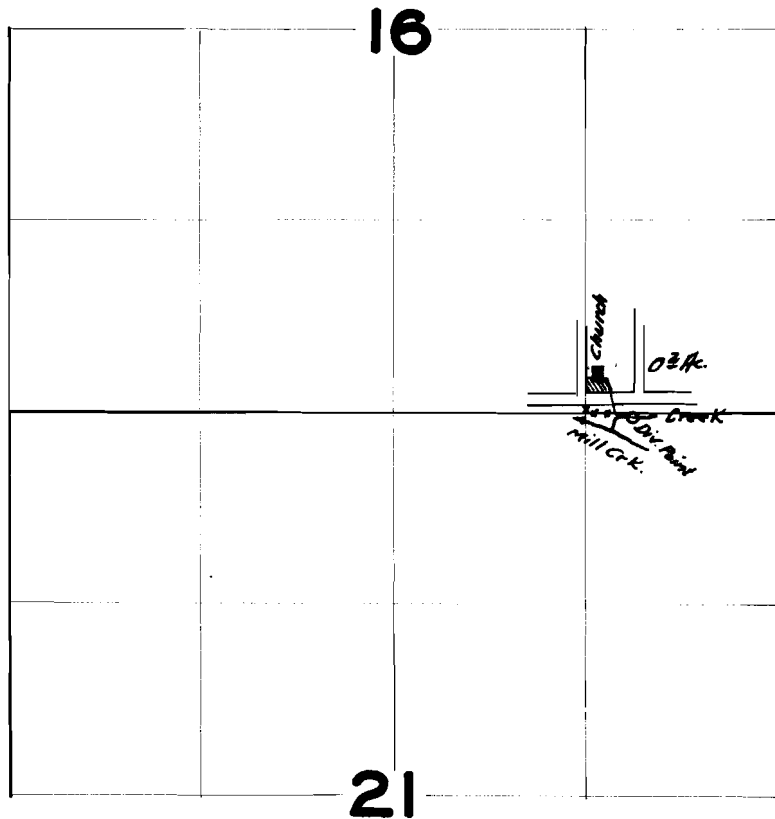

FINAL PROOF SURVEY UNDER

Application No. 24289. Permit No. 19053...
IN NAME OF

SOUTHERN IDAHO CONFERENCE ASSOC. OF SEVENTH DAY ADV.

Surveyed 10/23 1951, by H.L. COFFMAN.